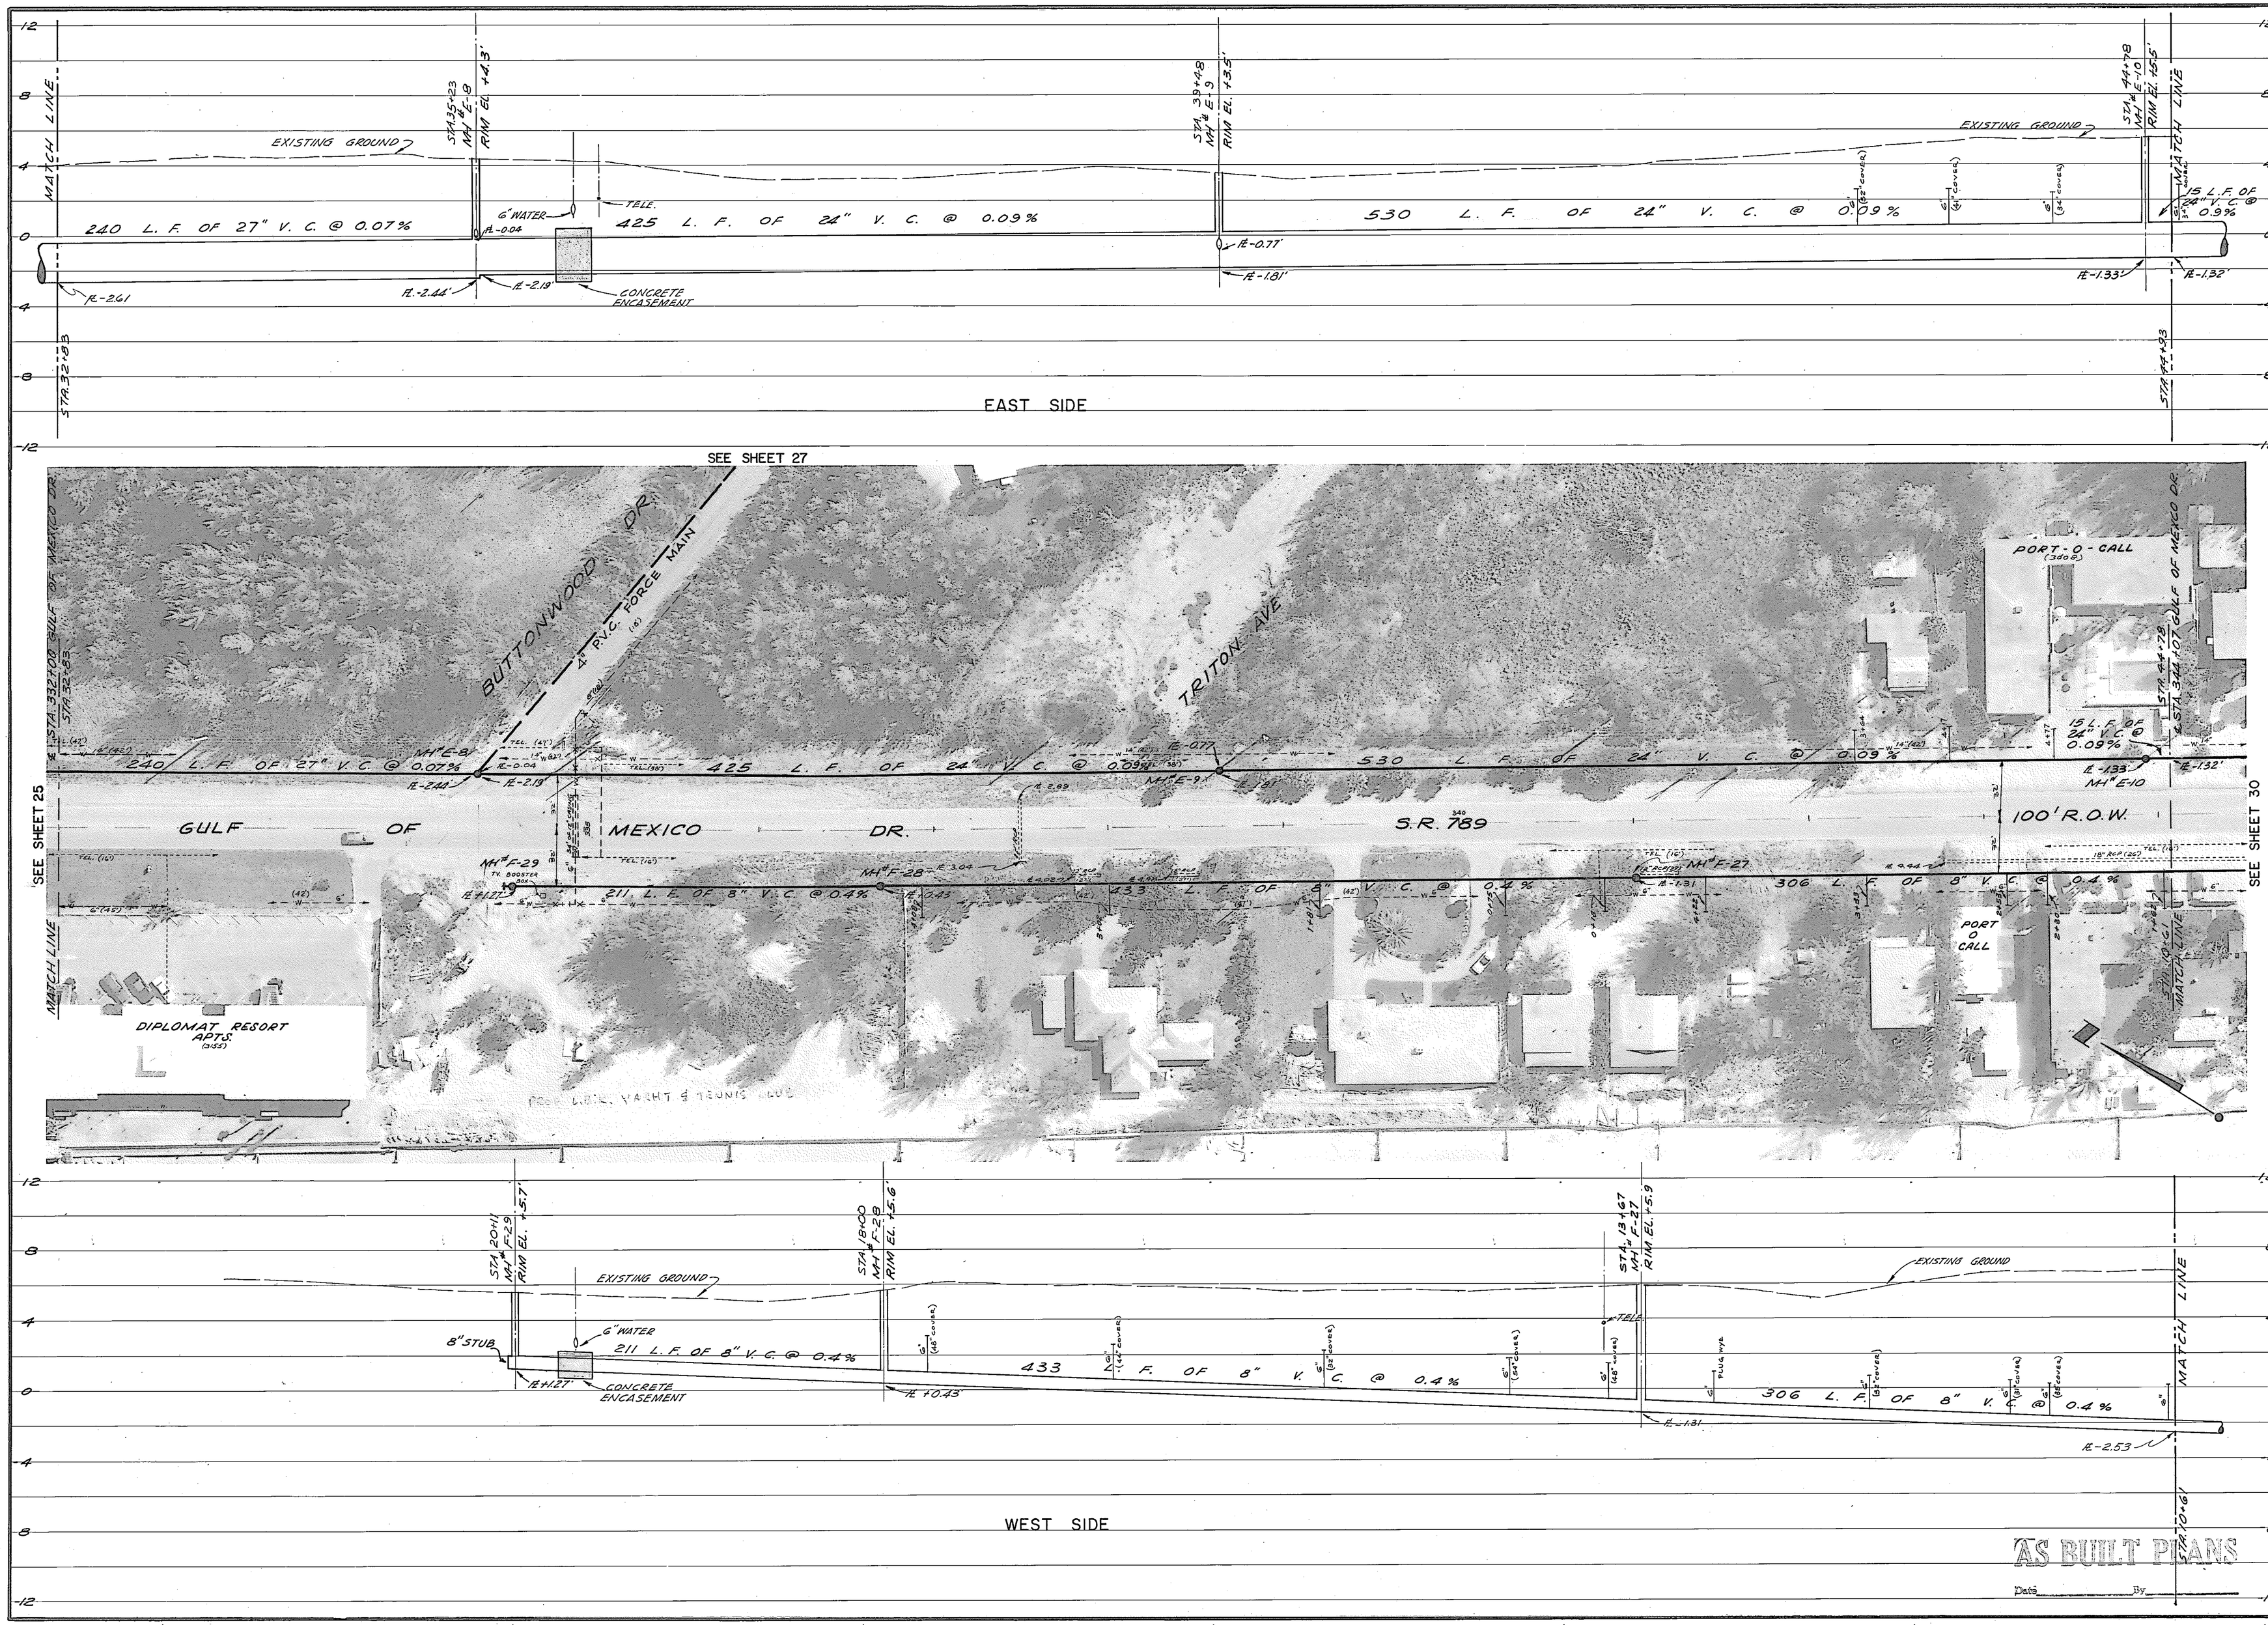

PHOTO: BOSWORTH AERIAL SURVEYS SEPT. 1972

APPROVED BY J. DAVID WEDGE, P.E. FLORIDA REGIST. NO. 15801

DESIGNED BY	PROJECT NO.
J.D.W., E.M.N. L.D.L.	1217-S

DATE	CHECKED BY
4-13-73	J.G., M.N. E.C.

SCALE:	DRAWN BY
HORIZ. 1" = 40' VERT. 1" = 8'	P.C.W.

LTR.	DATE	REVISION	BY
A	7/6/76	RELOCATED MH F-27 & ADDED SERVICES, AS BUILT	P.C.W.

FOR: TOWN OF LONGBOAT KEY, FLORIDA

GULF OF MEXICO DRIVE
W. MH F-29 TO MH F-27, E. MH E-8 TO MH E-10
WASTEWATER COLLECTION SYSTEM

SMALLY, WELLFORD & NALVEN — CONSULTING ENGINEERS — SARASOTA, FLORIDA

SHEET NUMBER 26

REVISION A

INDEX NO. E-1217-231