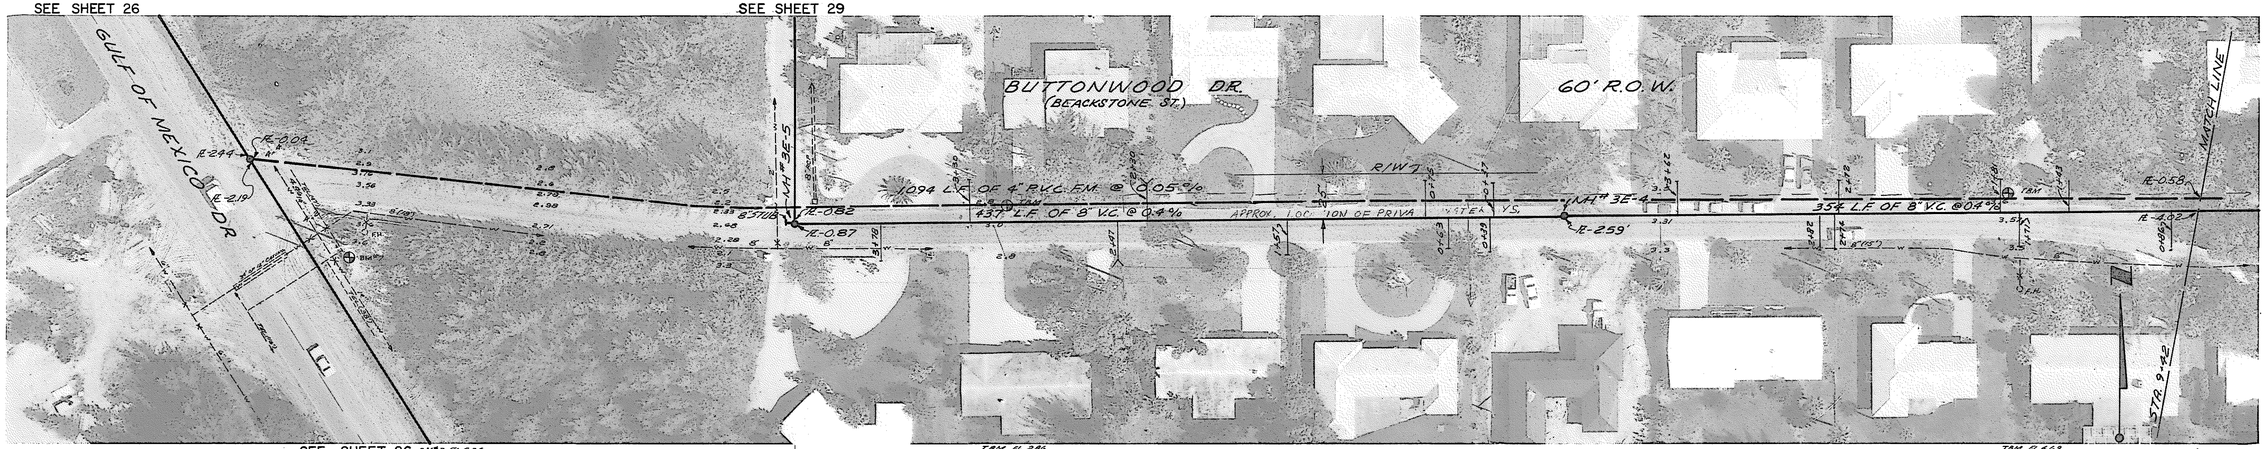

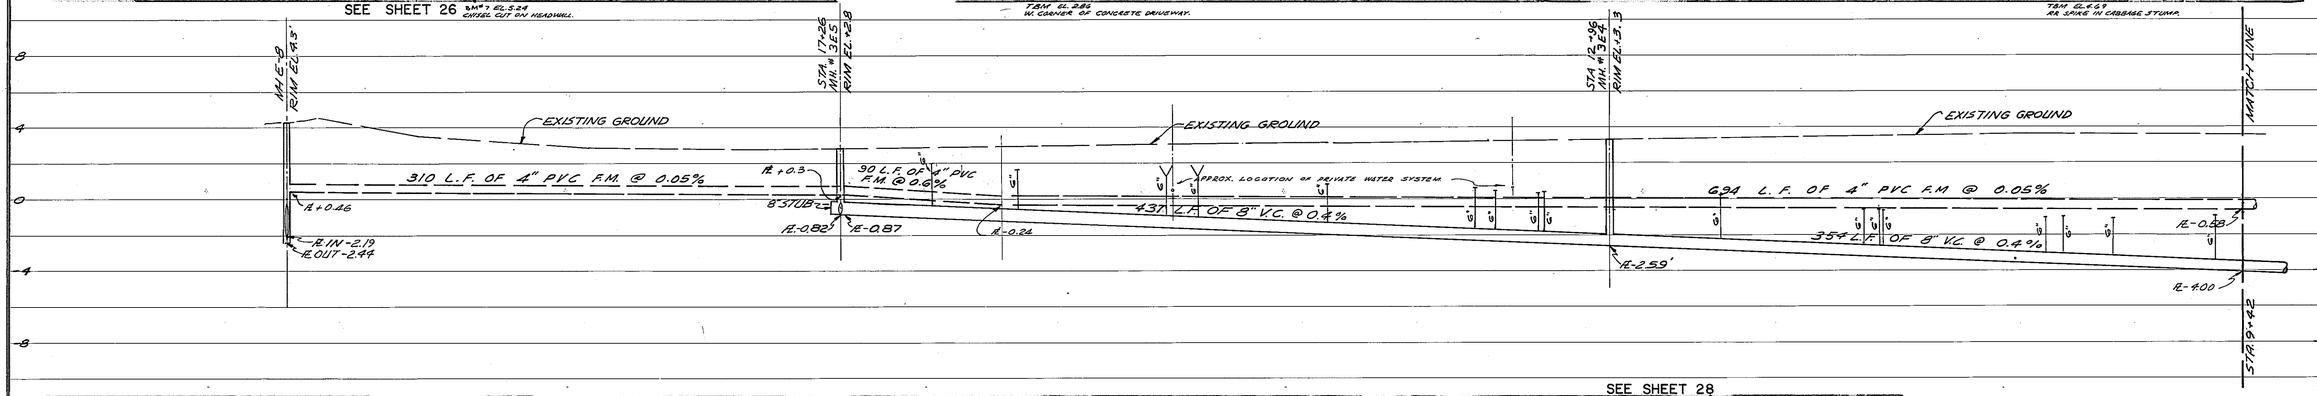

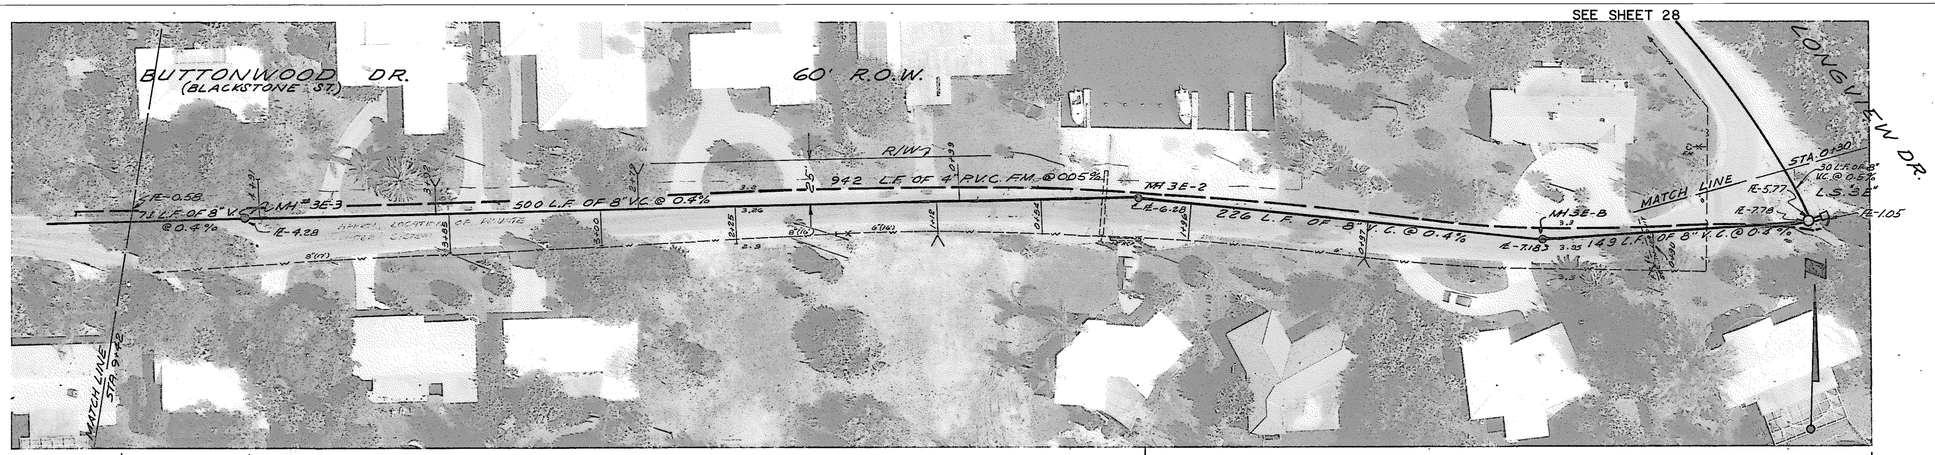

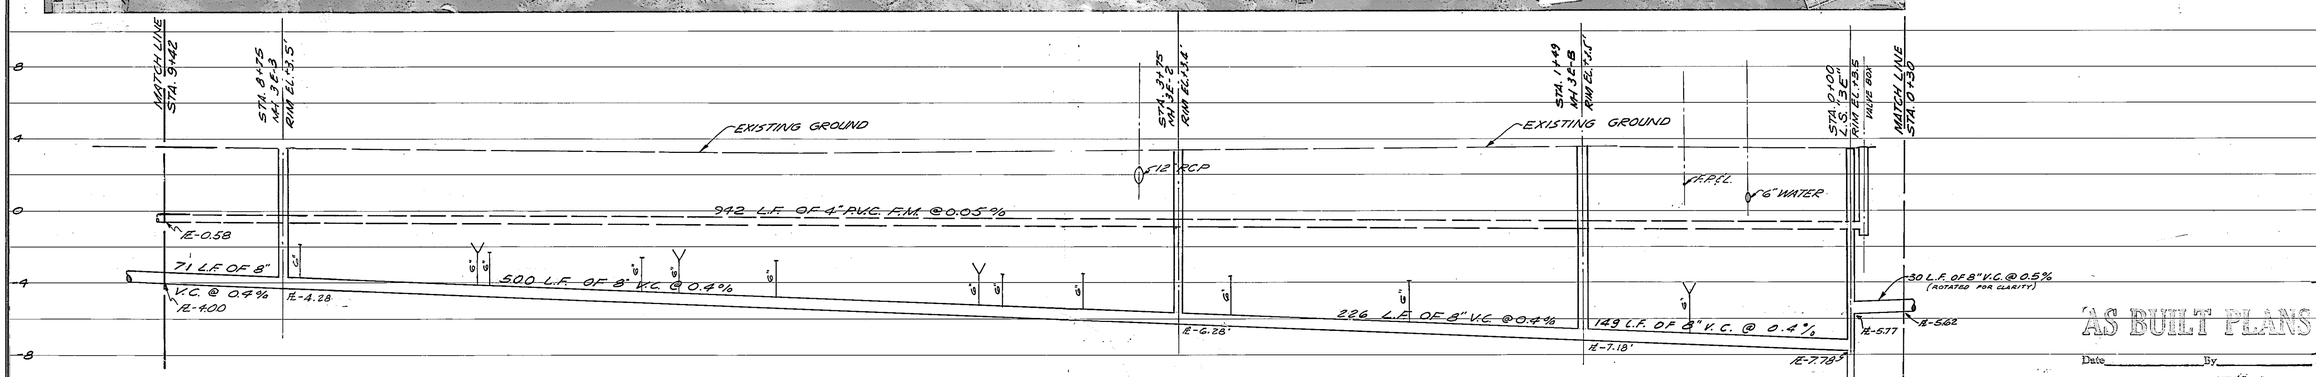

AS BUILT PLANS

Date _____ By _____

LTR.	DATE	REVISION
A	7-23-73	CHANGED FLOW LINE BETWEEN MH E-8 & MH 3E-5, ADDED VALVE BOX TO L.S. "3E"
B	7-15-75	ADDED MH 3E-6, RELOCATED MH 3E-2, 3 MH 3E-8, ADDED SERVICES

BY	SCALE:	DATE:	DESIGNED BY	PHOTO: BISSWANGER & DIGAL SURVEYS SEPT. 1972	APPROVED BY
L.D.L.	HORIZ. 1"=40' VERT. 1"=4'	4-13-73	LDL, RCW, EC		J. DAVID WEAGE, P.E. FLORIDA CERT. NO. 18,610
R.C.W.	DRAWN BY RCW	CHECKED BY LDL, MW, EC	PROJECT NO. 1217-S		

FOR: TOWN OF LONGBOAT KEY, FLORIDA

BUTTONWOOD DRIVE

WASTEWATER COLLECTION SYSTEM

SMALLY, WELLFORD & NALVEN—CONSULTING ENGINEERS—SARASOTA, FLORIDA

SHEET NUMBER 27

REVISION B

INDEX NO. E-1217-232