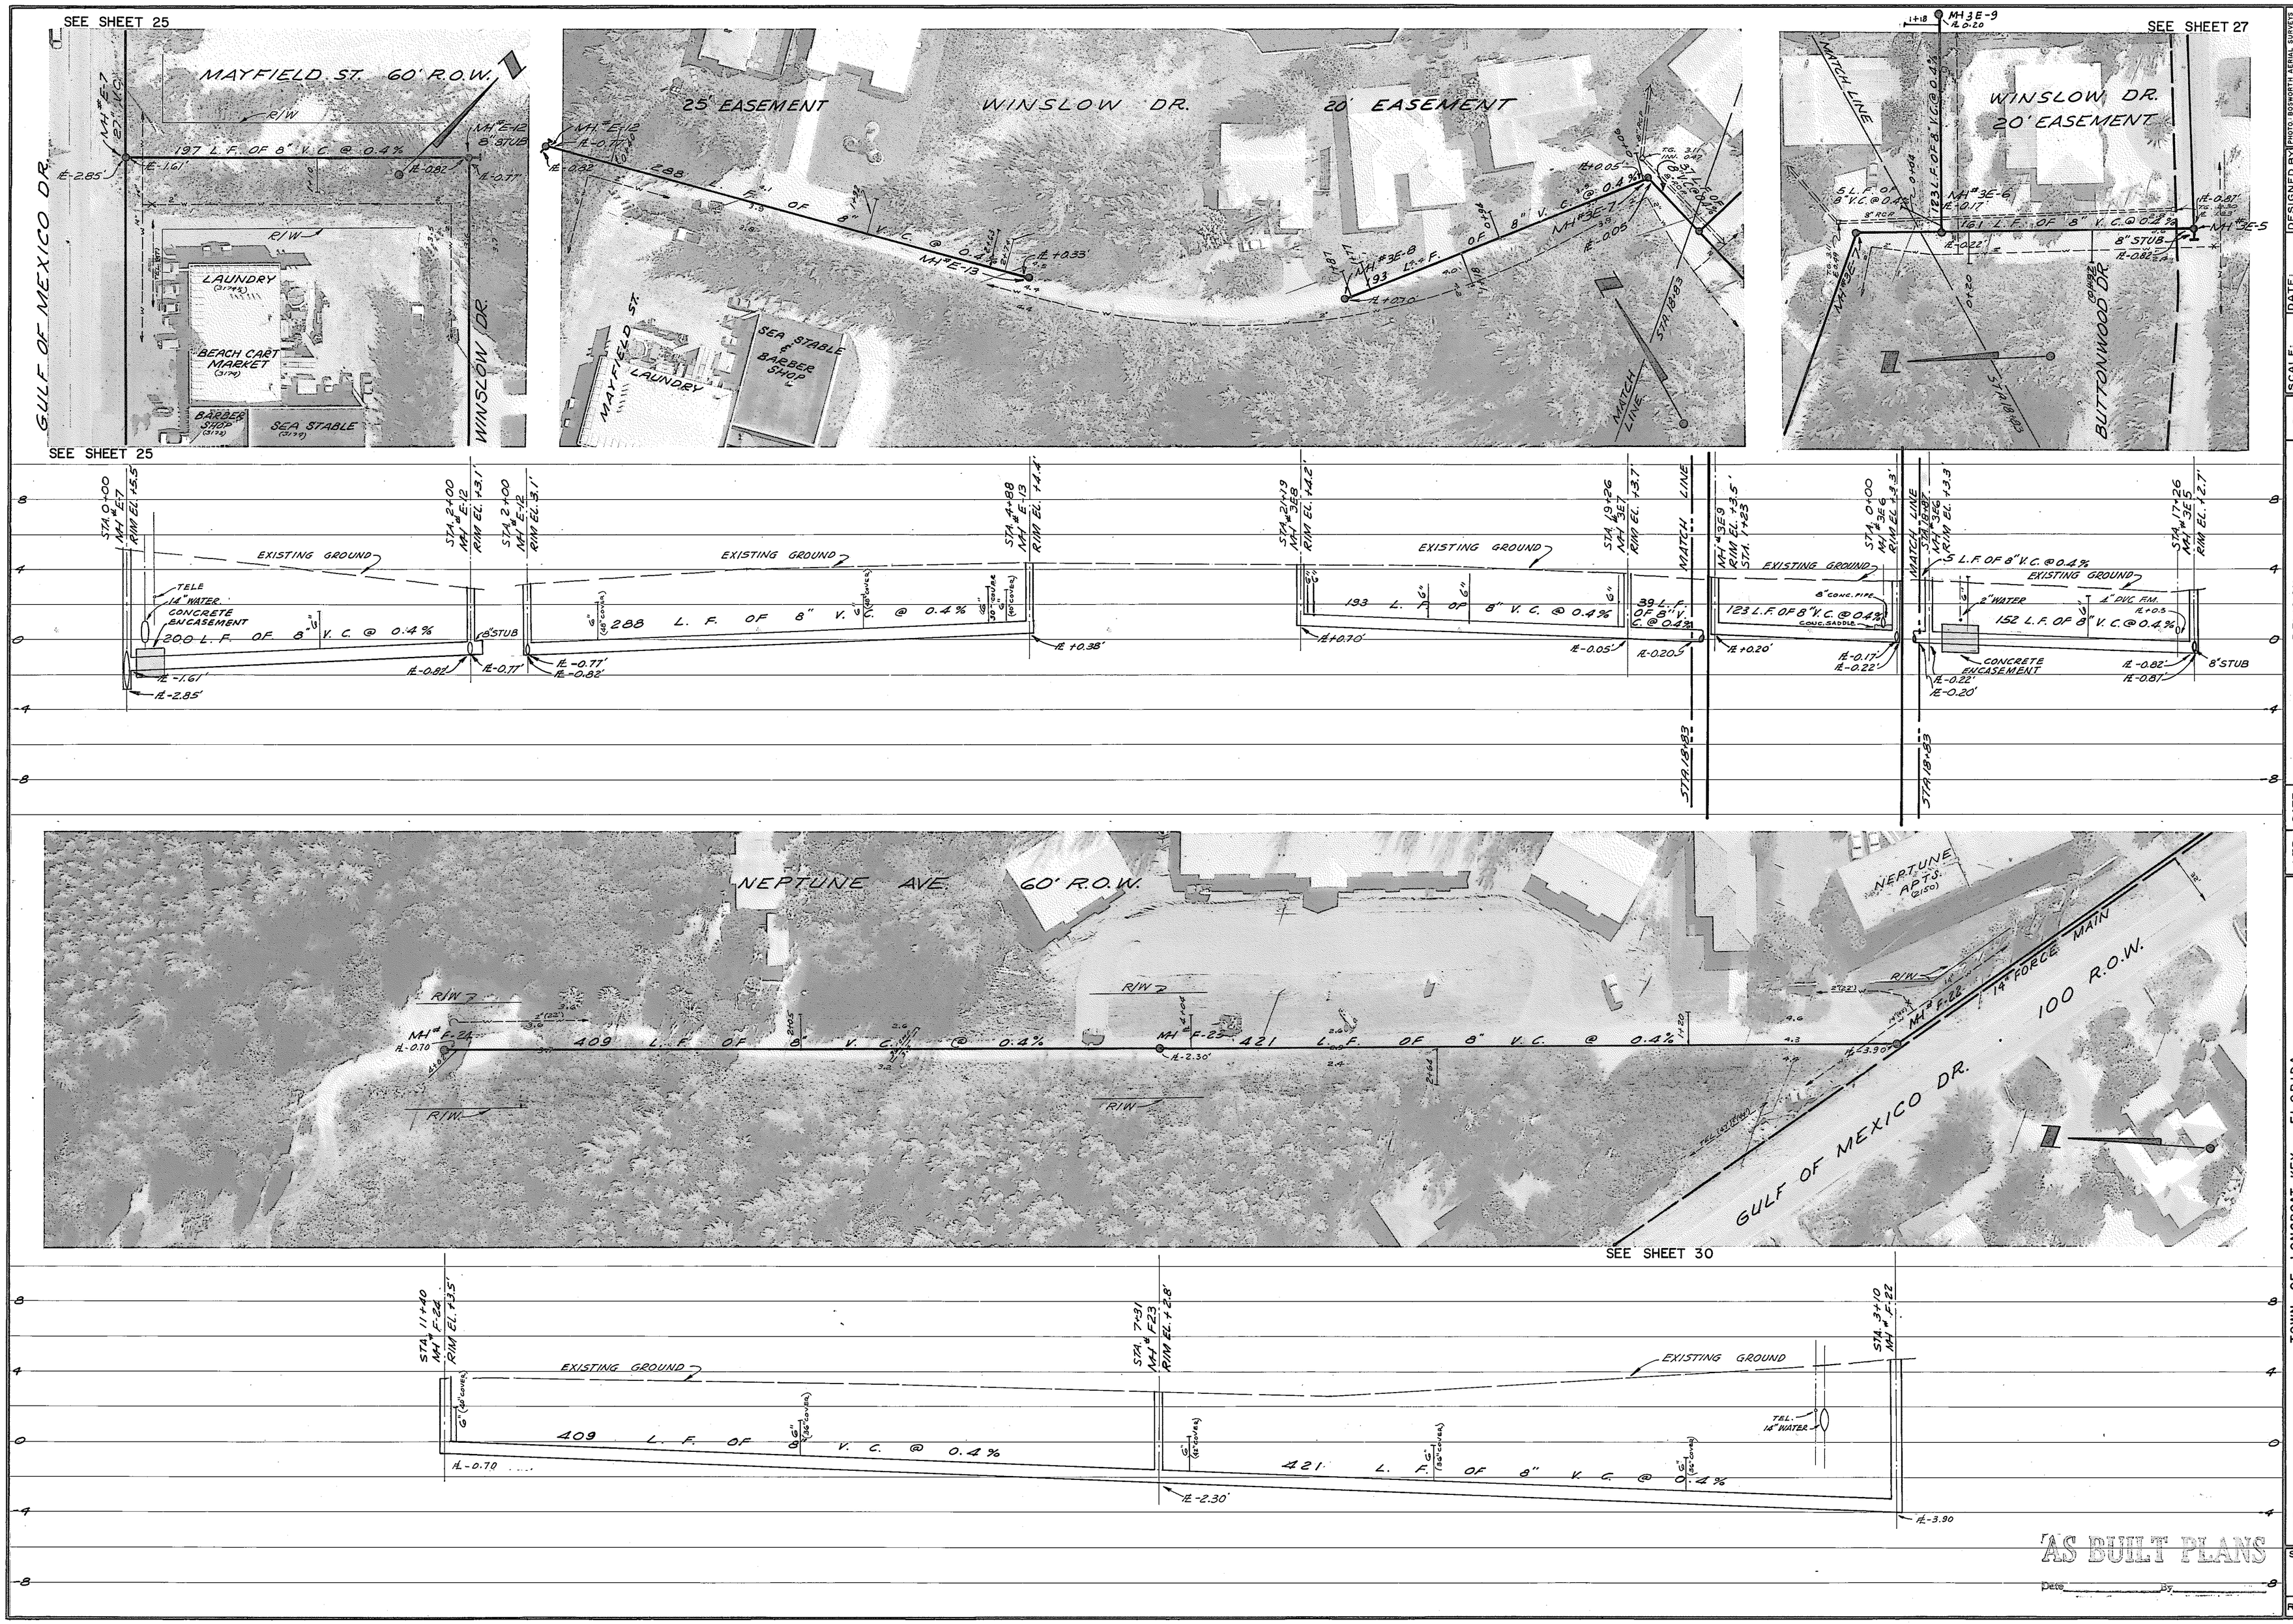

AS BUILT PLANS

Date _____ By _____

PHOTO: BOSWORTH AERIAL SURVEYS SEPT. 1972

APPROVED BY

J. DAVID WEAGE, P.E. FLORIDA CERT. NO. 13201

DESIGNED BY J.D.W., E.W.N., L.D.C.

PROJECT NO. 1217-S

DATE: 4-13-73

CHECKED BY J.G., M.W., E.C.

SCALE: HORIZ. 1"=40' VERT. 1"=4'

DRAWN BY P.C.W.

BY P.C.W. P.C.W.

REVISION

RELOCATED MH'S F-23, F-23, F-24 ALSO ADDED SERVICES. AS BUILT

DATE 7/8/75 12/8/72

LTR. A B

FOR: TOWN OF LONGBOAT KEY, FLORIDA

MAYFIELD ST., WINSLOW DR., NEPTUNE AVENUE

WASTEWATER COLLECTION SYSTEM

SMALLY, WELLFORD & NALVEN—CONSULTING ENGINEERS—SARASOTA, FLORIDA

SHEET NUMBER 29

REVISION 'B'

INDEX NO. E-1217-234