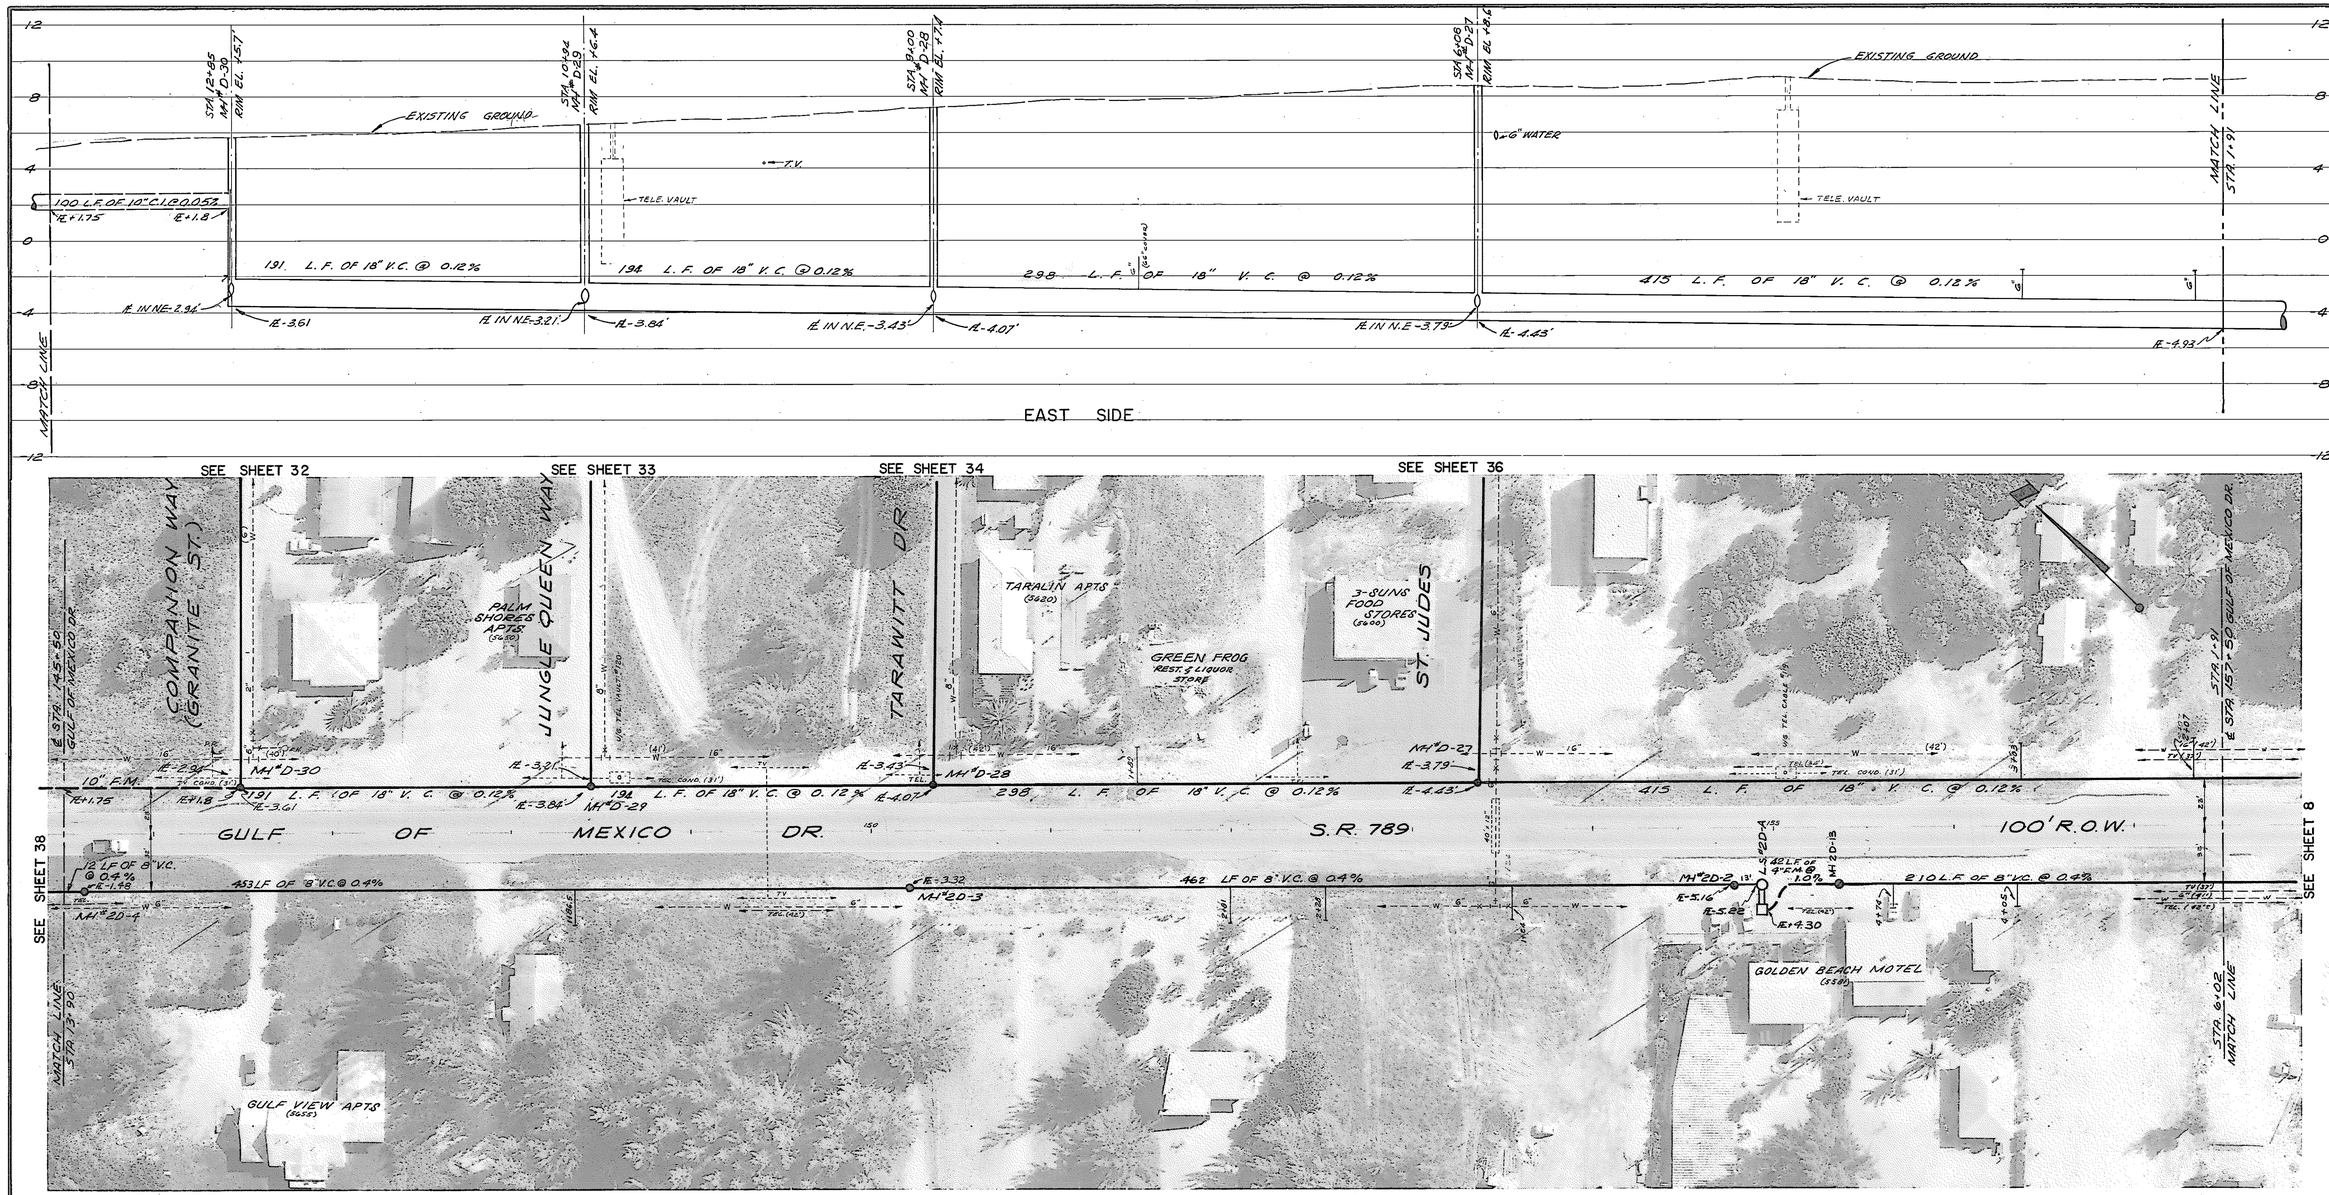

AS BUILT PLANS

REVISION			
LTR.	DATE		BY
"A"	1-15-74	REVISED FLOW LINE @ JUNGLE QUEEN WAY	L.D.L.
"B"	1-31-74	" " " "	L.D.L.
"C"	10-25-74	LOCATE L.S. "2D-A", MH. 2D-13 & FORCE MAIN	L.D.L.
"D"	11-8-74	RELOCATE MH #2D-13, & SHORTEN F.M.	
"E"	1-17-75	REVISED MH #2D-4 & ADD MH #2D-1B, AS BUILT	

PHOTO: EDSMORTH AERIAL SURVEYS SEPT. 1972

APPROVED BY J. DAVID VEAGE, P.E. FLORIDA CERT. NO. 13,801

DESIGNED BY J.D.V. DRAWN BY L.D.L. CHECKED BY J.D.V.

DATE: 4-13-73

SCALE: HORIZ. 1" = 40' VERT. 1" = 4'

DRAWN BY P.C.W.

PROJECT NO. 1217-S

SMALLY, WELLFORD & NALVEN — CONSULTING ENGINEERS — SARASOTA, FLORIDA

FOR: TOWN OF LONGBOAT KEY, FLORIDA

GULF OF MEXICO DRIVE
W. MH 2D-4 TO MH 2D-2, E MH D-30 TO MH D-27
WASTEWATER COLLECTION SYSTEM

SHEET NUMBER 31

REVISION "E"

INDEX NO. E-1217-239