SEE SHEET 36 SEE SHEET 37

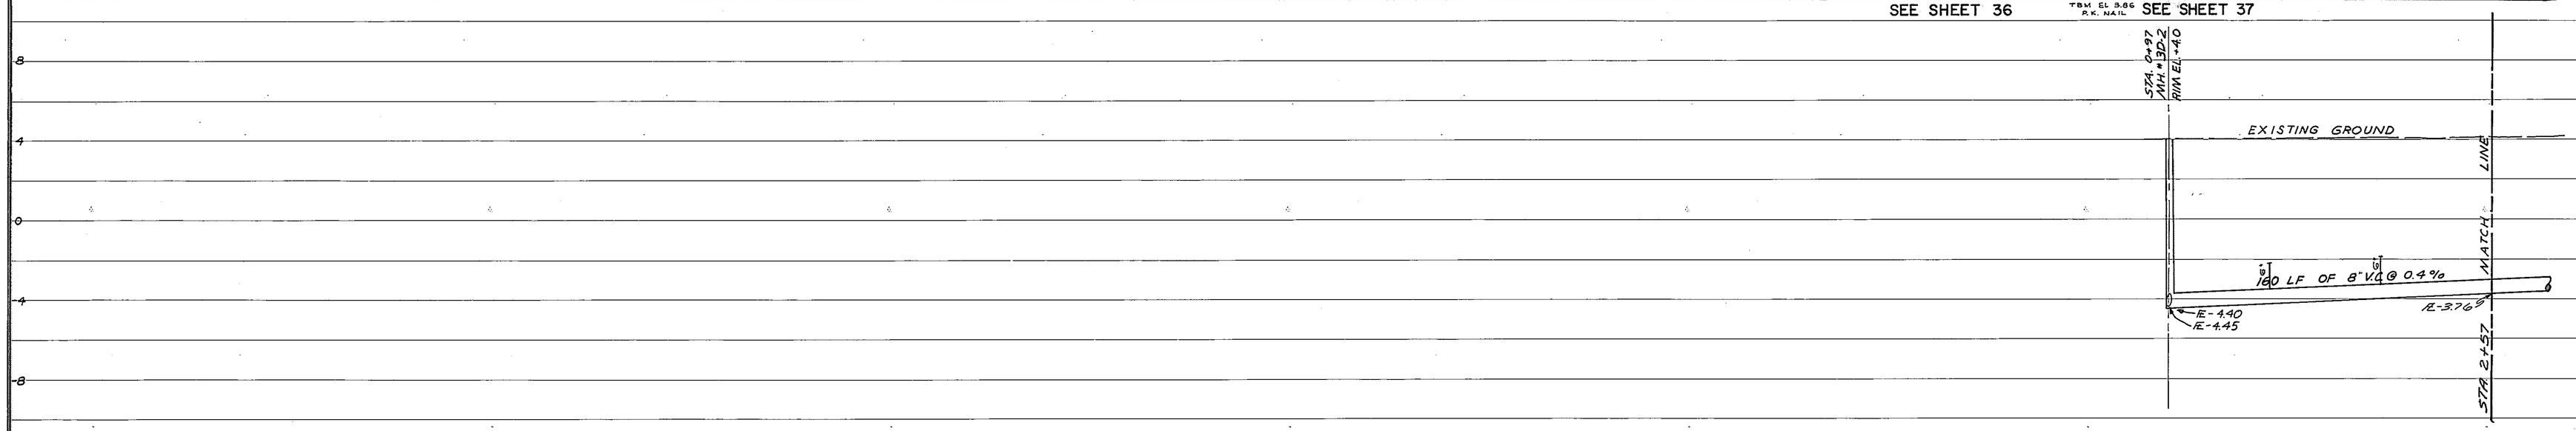

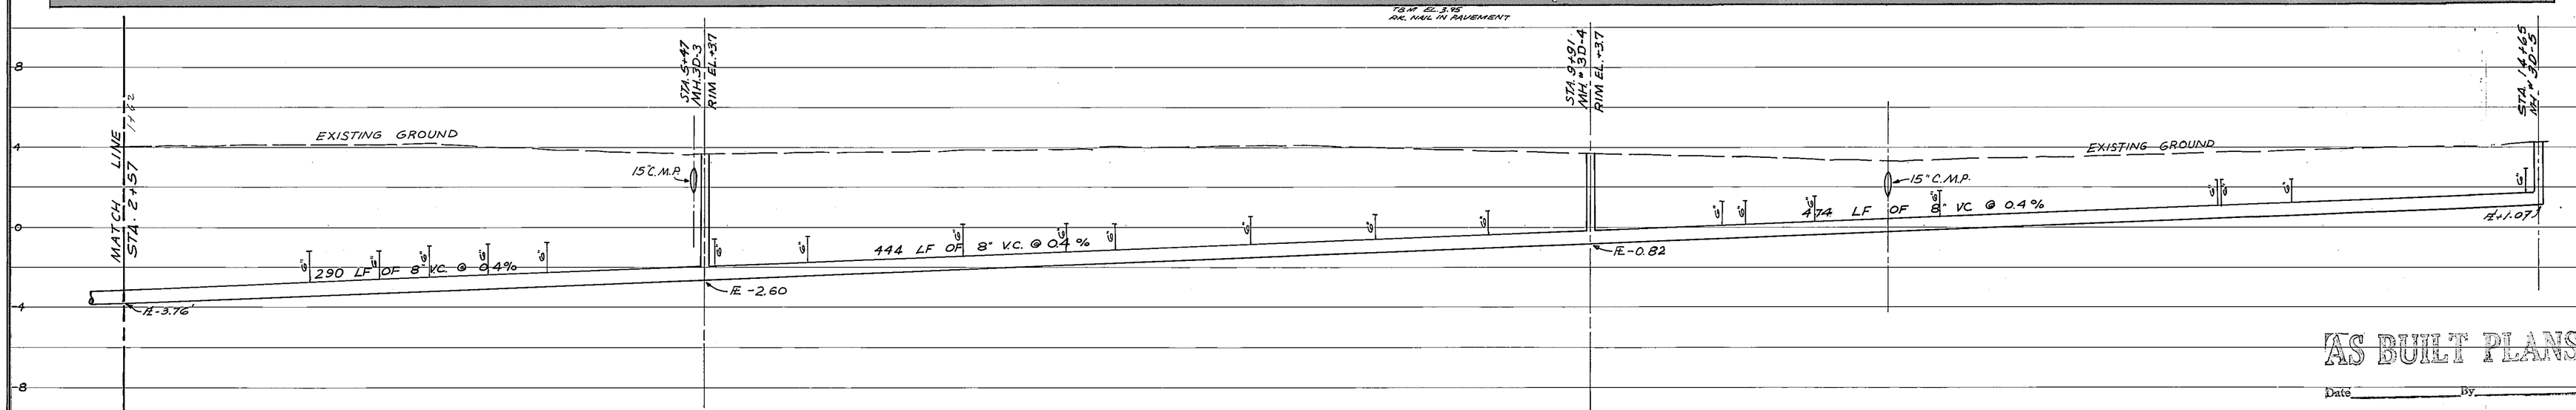

AS BUILT PLANS

Date_____ By_____

PHOTO: BOSWORTH AERIAL SURVEYS SEPT. 1972	APPROVED BY
DESIGNED BY J.D.W., E.W.N. L.D.C.	J. DAVID WEAGE, P.E. FLORIDA CERT. NO. 13001
DATE: 4-13-73	PROJECT NO. 1217-S
SCALE: HORIZ. 1"=40' VERT. 1"=4'	CHECKED BY L.C.B., M.W. E.C.
DRAWN BY H.M.G.	

BY	REVISION
P.R.N.J.	

LTR.	DATE	
A	6-25-74	AS BUILT

FOR: TOWN OF LONGBOAT KEY, FLORIDA

ST. JUDES NORTH

WASTEWATER COLLECTION SYSTEM

SMALLY, WELLFORD & NALVEN — CONSULTING ENGINEERS — SARASOTA, FLORIDA

SHEET NUMBER 35

REVISION

INDEX NO. E-1217-240