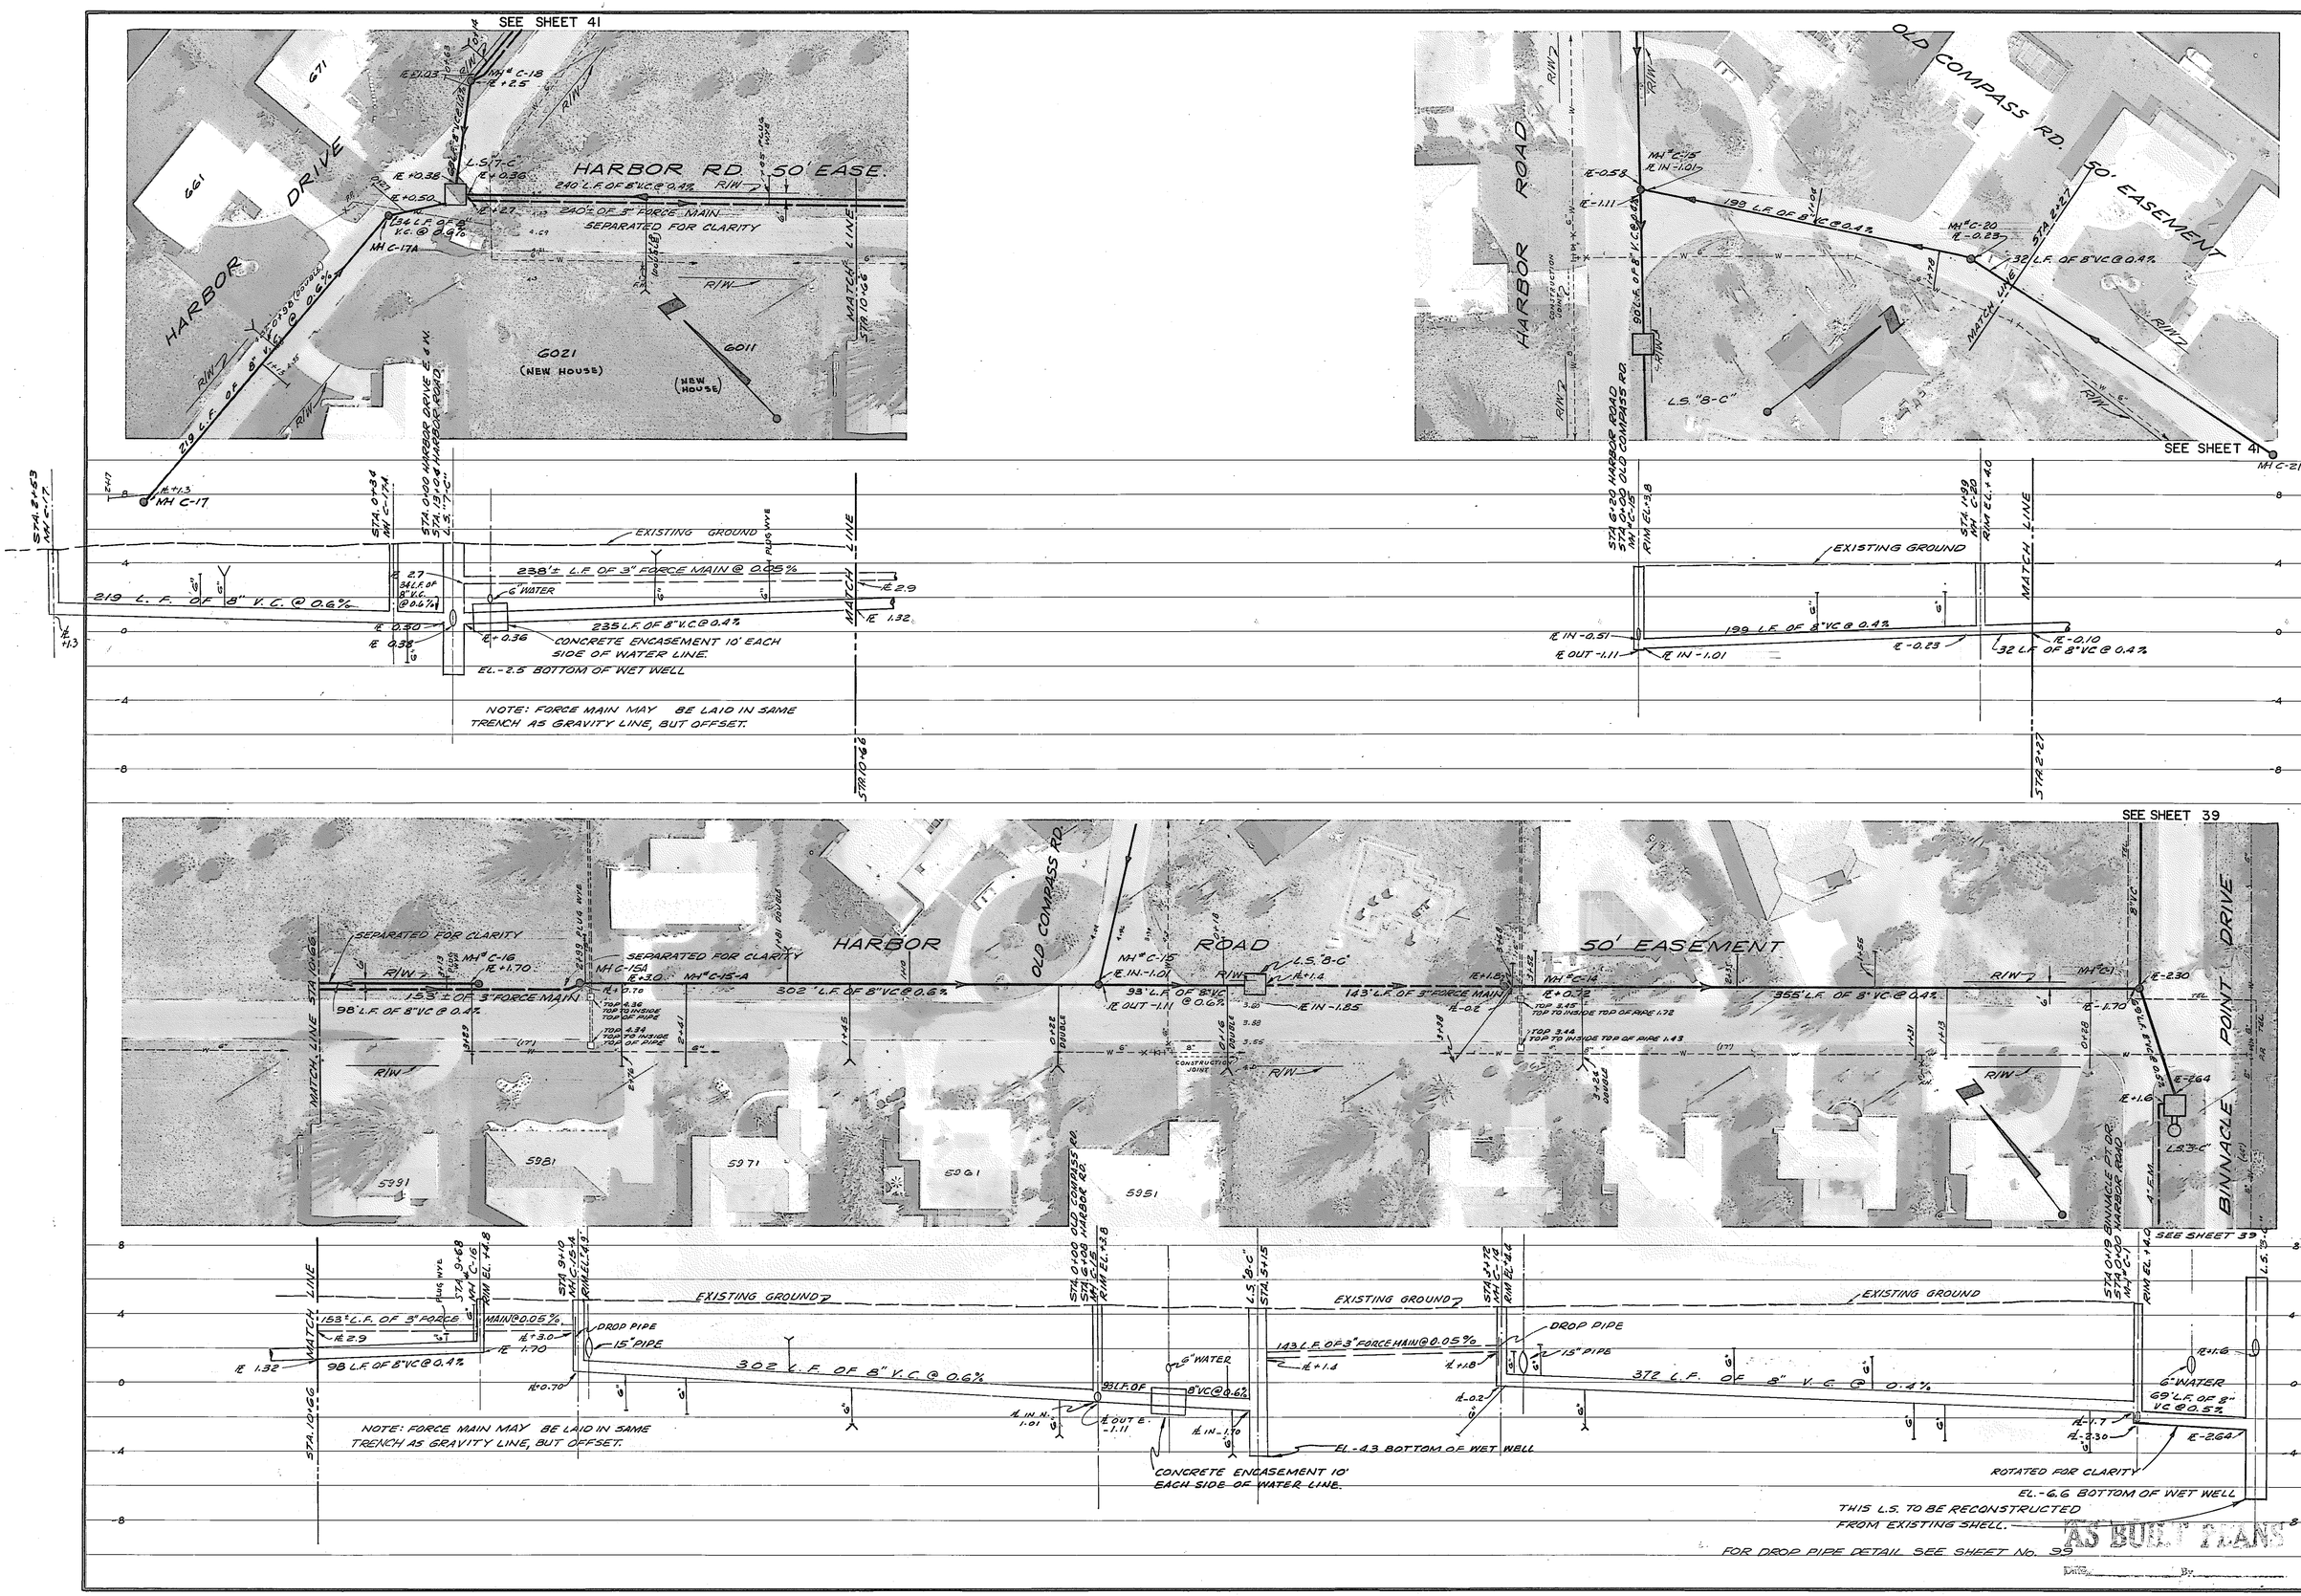

PHOTO: BOSWORTH AERIAL SURVEYS SEPT. 1972

APPROVED BY

J. DAVID WEDGE P.E. FLORIDA CERT. NO. 13101

DESIGNED BY	DATE	SCALE:	BY
J.D.W., E.M.N. L.D.C.	4-19-73	HORIZ. 1" = 40' VERT. 1" = 4'	

PROJECT NO.	CHECKED BY	DRAWN BY
1217-S	J.G., M.N. Z.C.	P.C.W.

LTR.	DATE	REVISION	BY
A	7-19-73	MOVED L.S. "C" & ADDED VALVE BOX	L.D.L.
B	2-19-74	ADDED M.H. "C-1" STA. 1+75	L.D.L.
C	10-28-74	REVISED GRAVITY LINES AND FORCE MAINS.	
D	1-6-75	REVISED GRAVITY LINES AND FORCE MAINS ON OLD COMPASS RD.	
E	1-29-75	REVISED L.S. "8-C" & ADDED L.S. "3-C"	

FOR: TOWN OF LONGBOAT KEY, FLORIDA

HARBOR ROAD, OLD COMPASS ROAD
WASTEWATER COLLECTION SYSTEM

SMALLY, WELLFORD & NALVEN — CONSULTING ENGINEERS — SARASOTA, FLORIDA

SHEET NUMBER 40

REVISION E

INDEX NO. E-1217-245