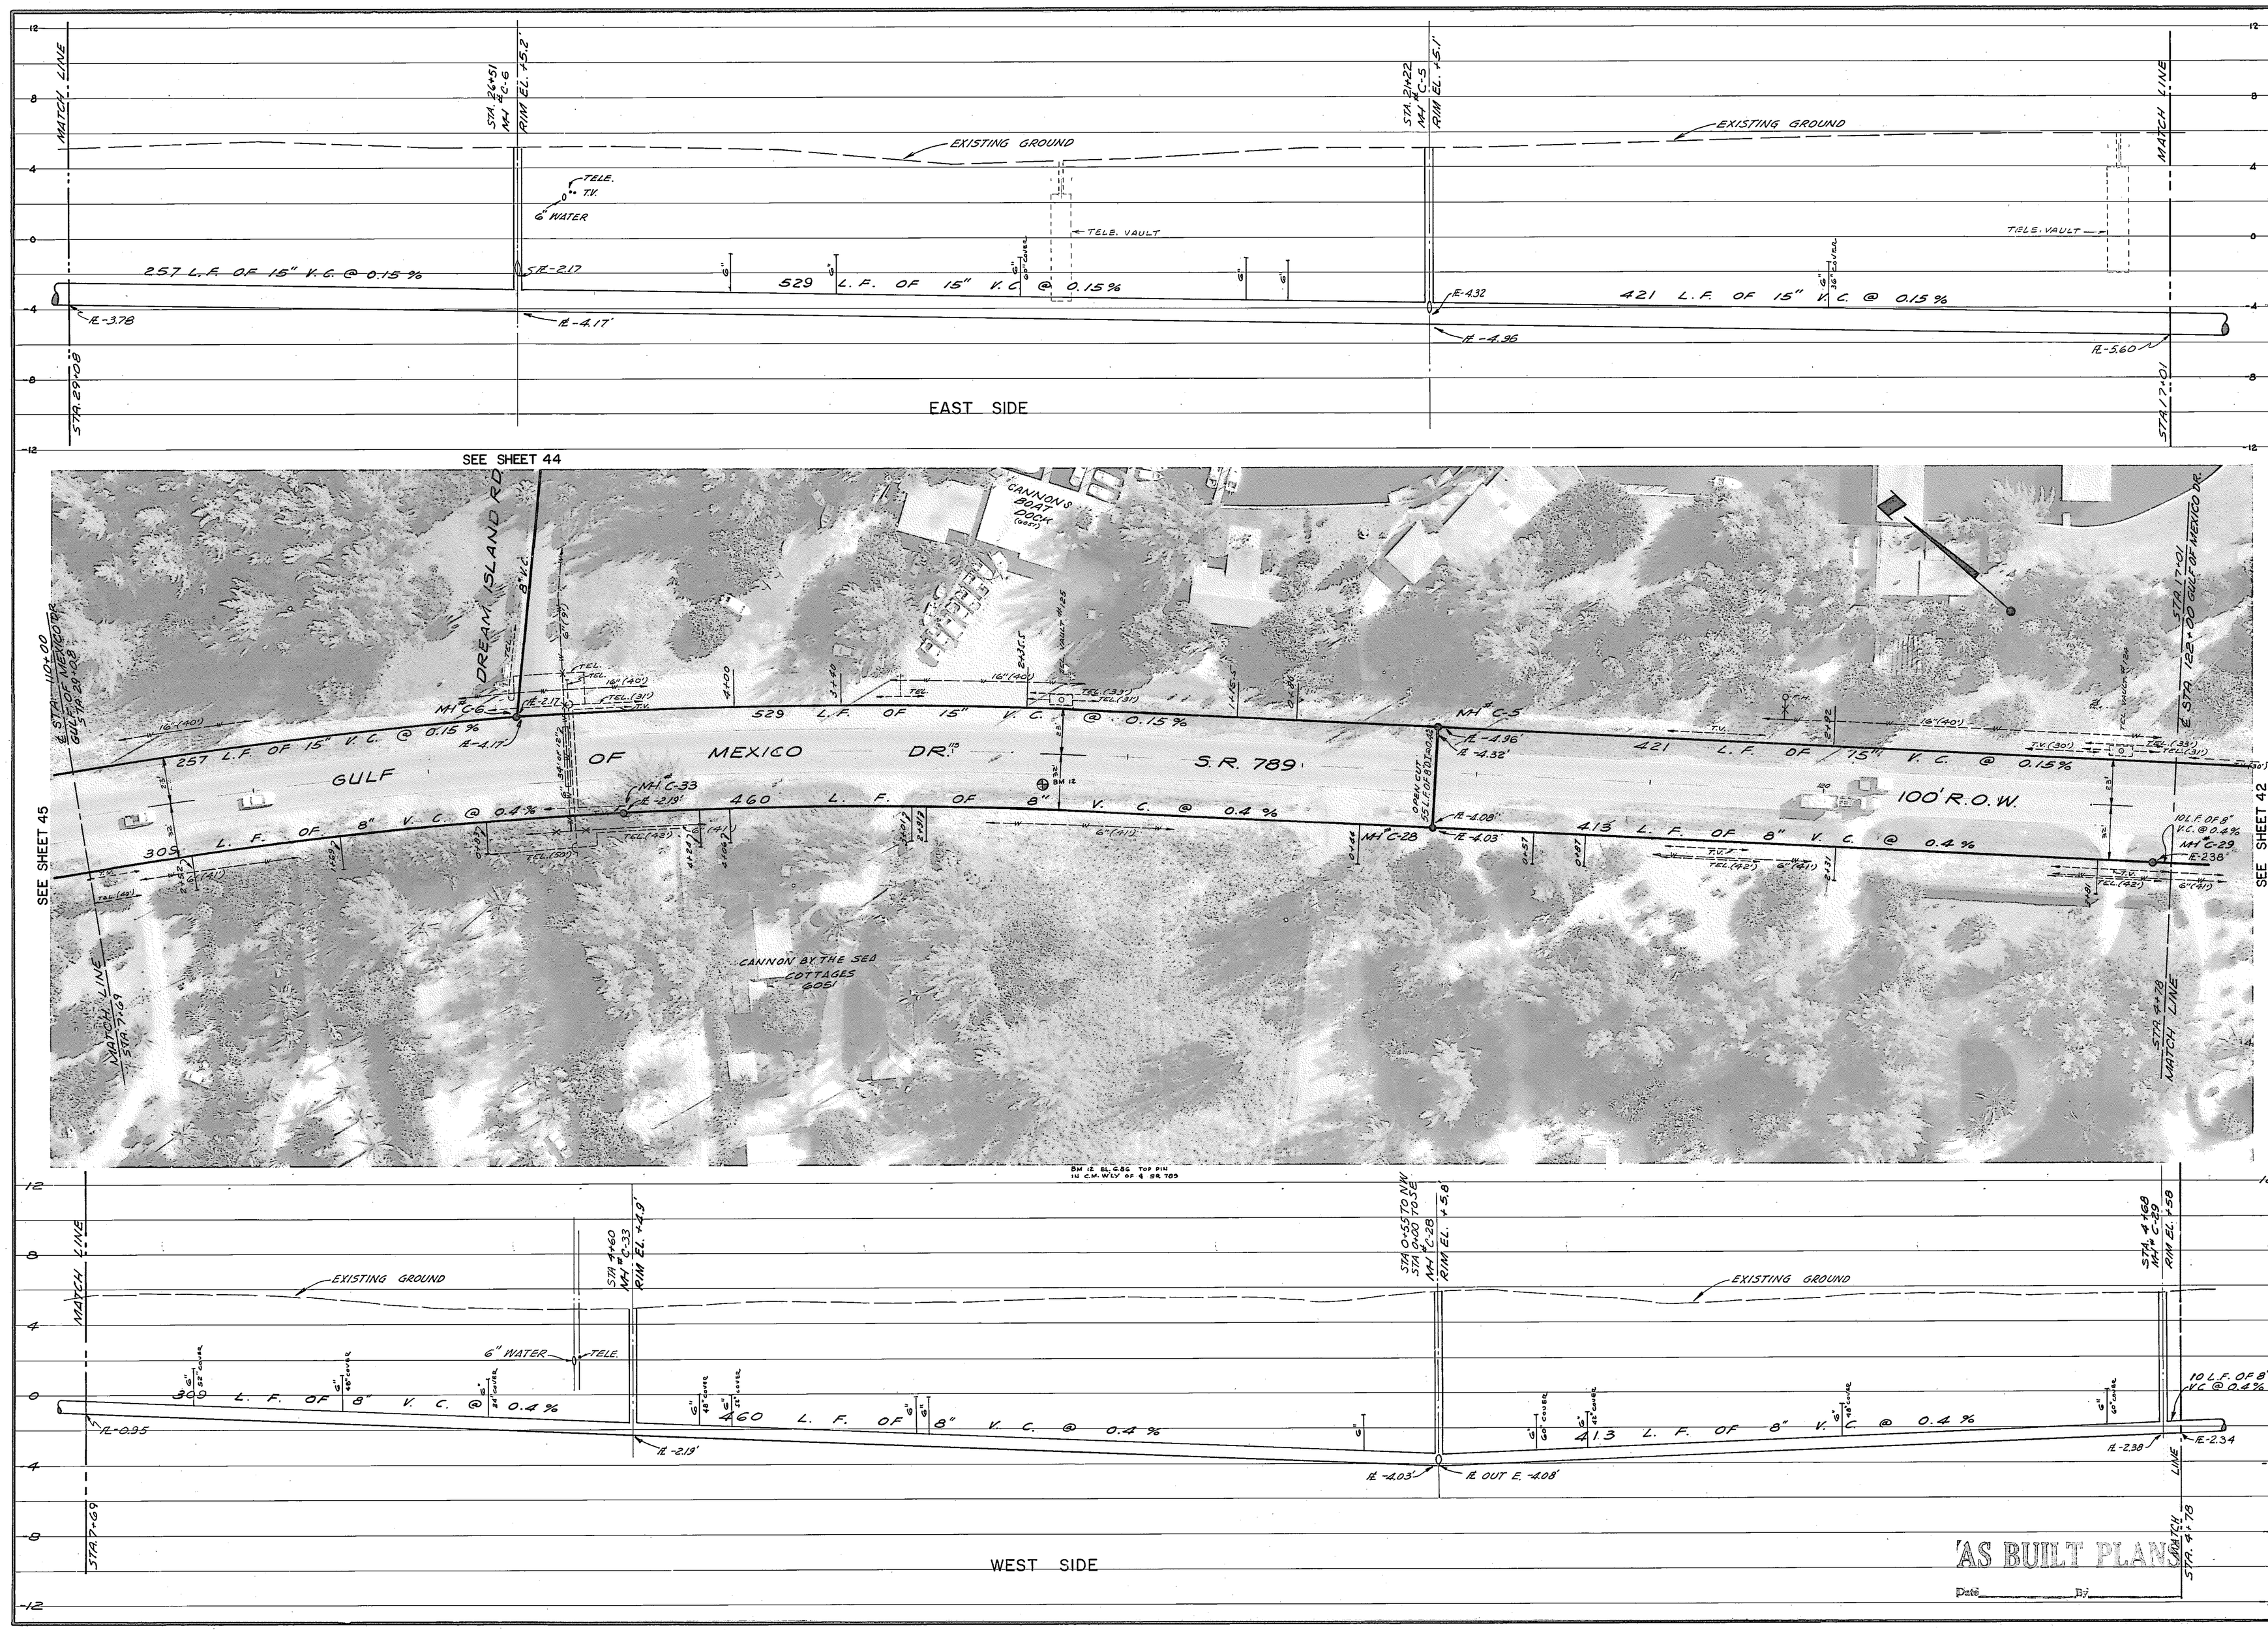

PHOTO FOGSMITH AERIAL SURVEYS SEPT. 1972

APPROVED BY

J. DAVID WEAGE, P.E. FLORIDA REG. NO. 20801

DESIGNED BY J.W. EWN L.G.L.

DATE: 4-13-73

CHECKED BY J.G. MUK E.C.

PROJECT NO. 1217-S

SCALE: HORIZ. 1"=40' VERT. 1"=4'

DRAWN BY P.C.W.

LTR.	DATE	REVISION	BY
A	8-15-75	ADDED SERVICES	P.C.W.

FOR: TOWN OF LONGBOAT KEY, FLORIDA

GULF OF MEXICO DRIVE
W. MH C-33 TO MH C-29, E. MH C-6 TO MH C-5
WASTEWATER COLLECTION SYSTEM

SMALLY, WELLFORD & NALVEN — CONSULTING ENGINEERS — SARASOTA, FLORIDA

SHEET NUMBER 43

REVISION A

INDEX NO. E-1217-248