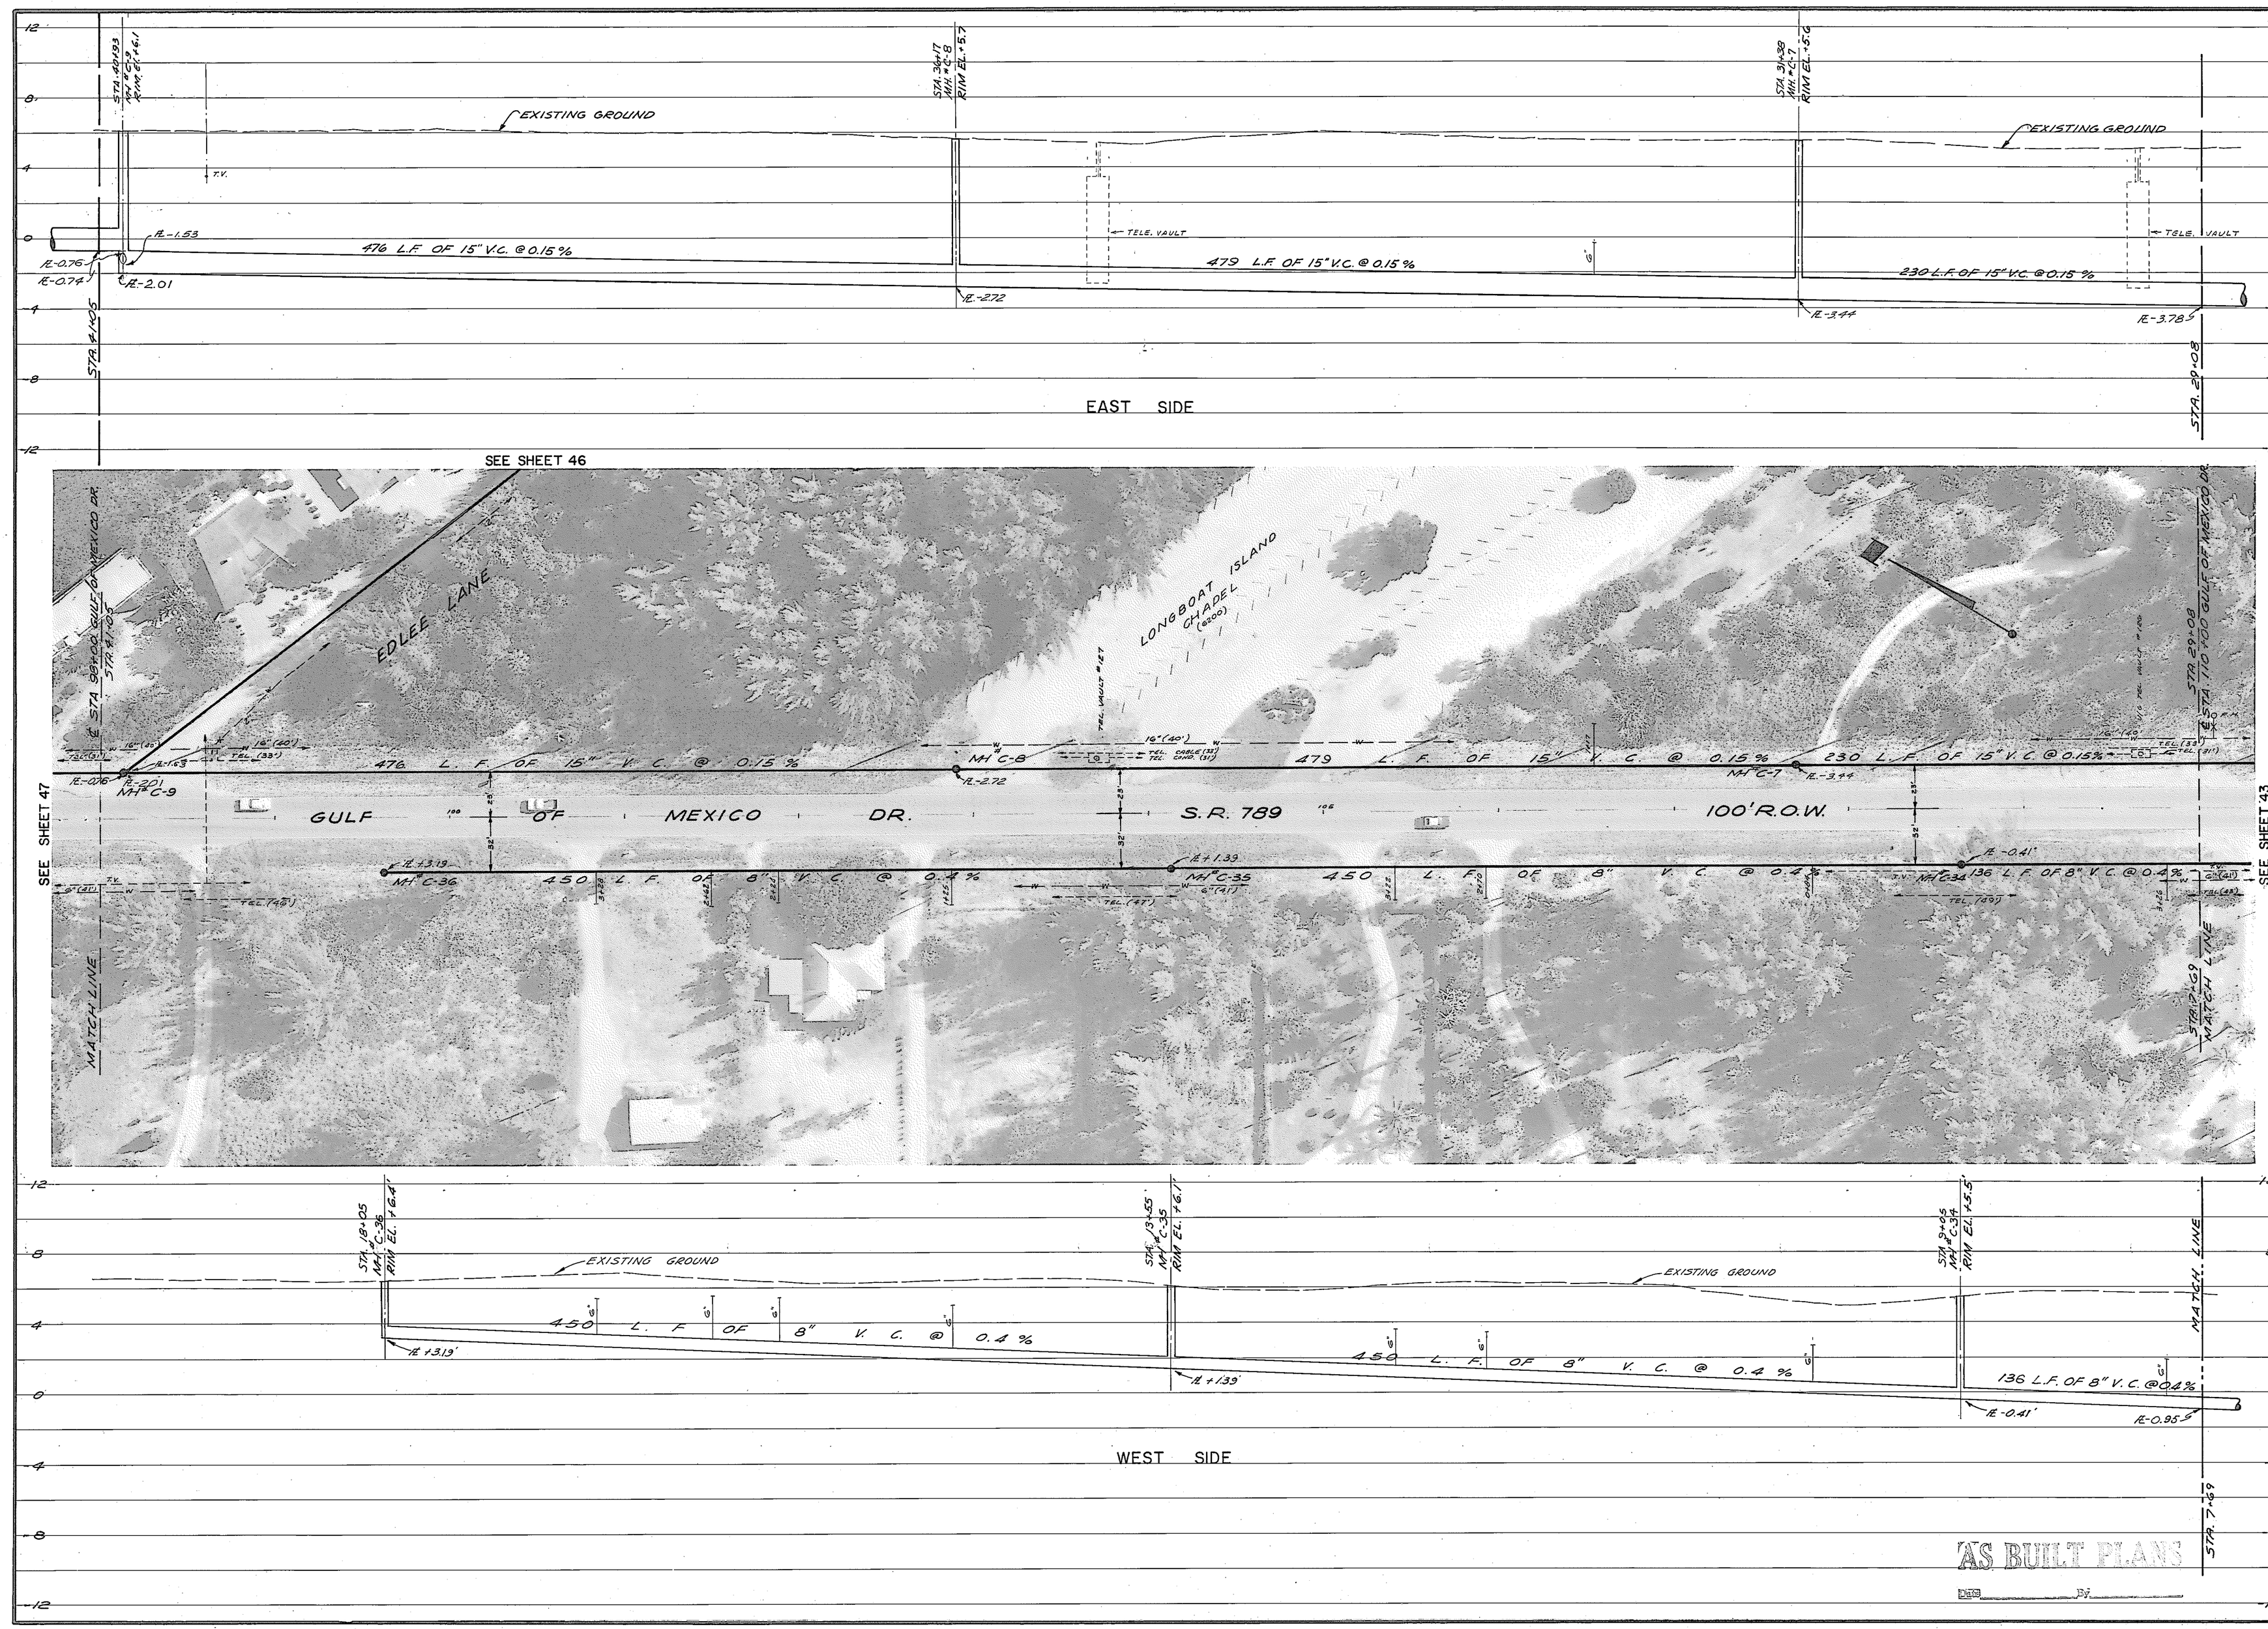

AS BUILT PLANS

DATE _____ BY _____

PHOTO: LOSSMYTH AERIAL SURVEYS SEPT. 1972

APPROVED BY

J. DAVID WEAGE, P.E.
J. DAVID WEAGE, INC.

DESIGNED BY: J.D.W., L.F.W.N., L.D.L.

DATE: 4-13-73

CHECKED BY: L.G., M.W., E.C.

PROJECT NO. 1217-S

SCALE: HORIZ. 1"=40' VERT. 1"=4'

DRAWN BY: P.C.W.

BY	REVISION	LTR.	DATE
P.C.W.		'A'	2-13-75
	AS BUILT		

FOR: TOWN OF LONGBOAT KEY, FLORIDA

GULF OF MEXICO DRIVE

W. MH C-36 TO MH C-34, E. MH C-9 TO MH C-7

WASTEWATER COLLECTION SYSTEM

SMALLY, WELLFORD & NALVEN — CONSULTING ENGINEERS — SARASOTA, FLORIDA

SHEET NUMBER 45

REVISION 'A'

INDEX NO. E-1217-250