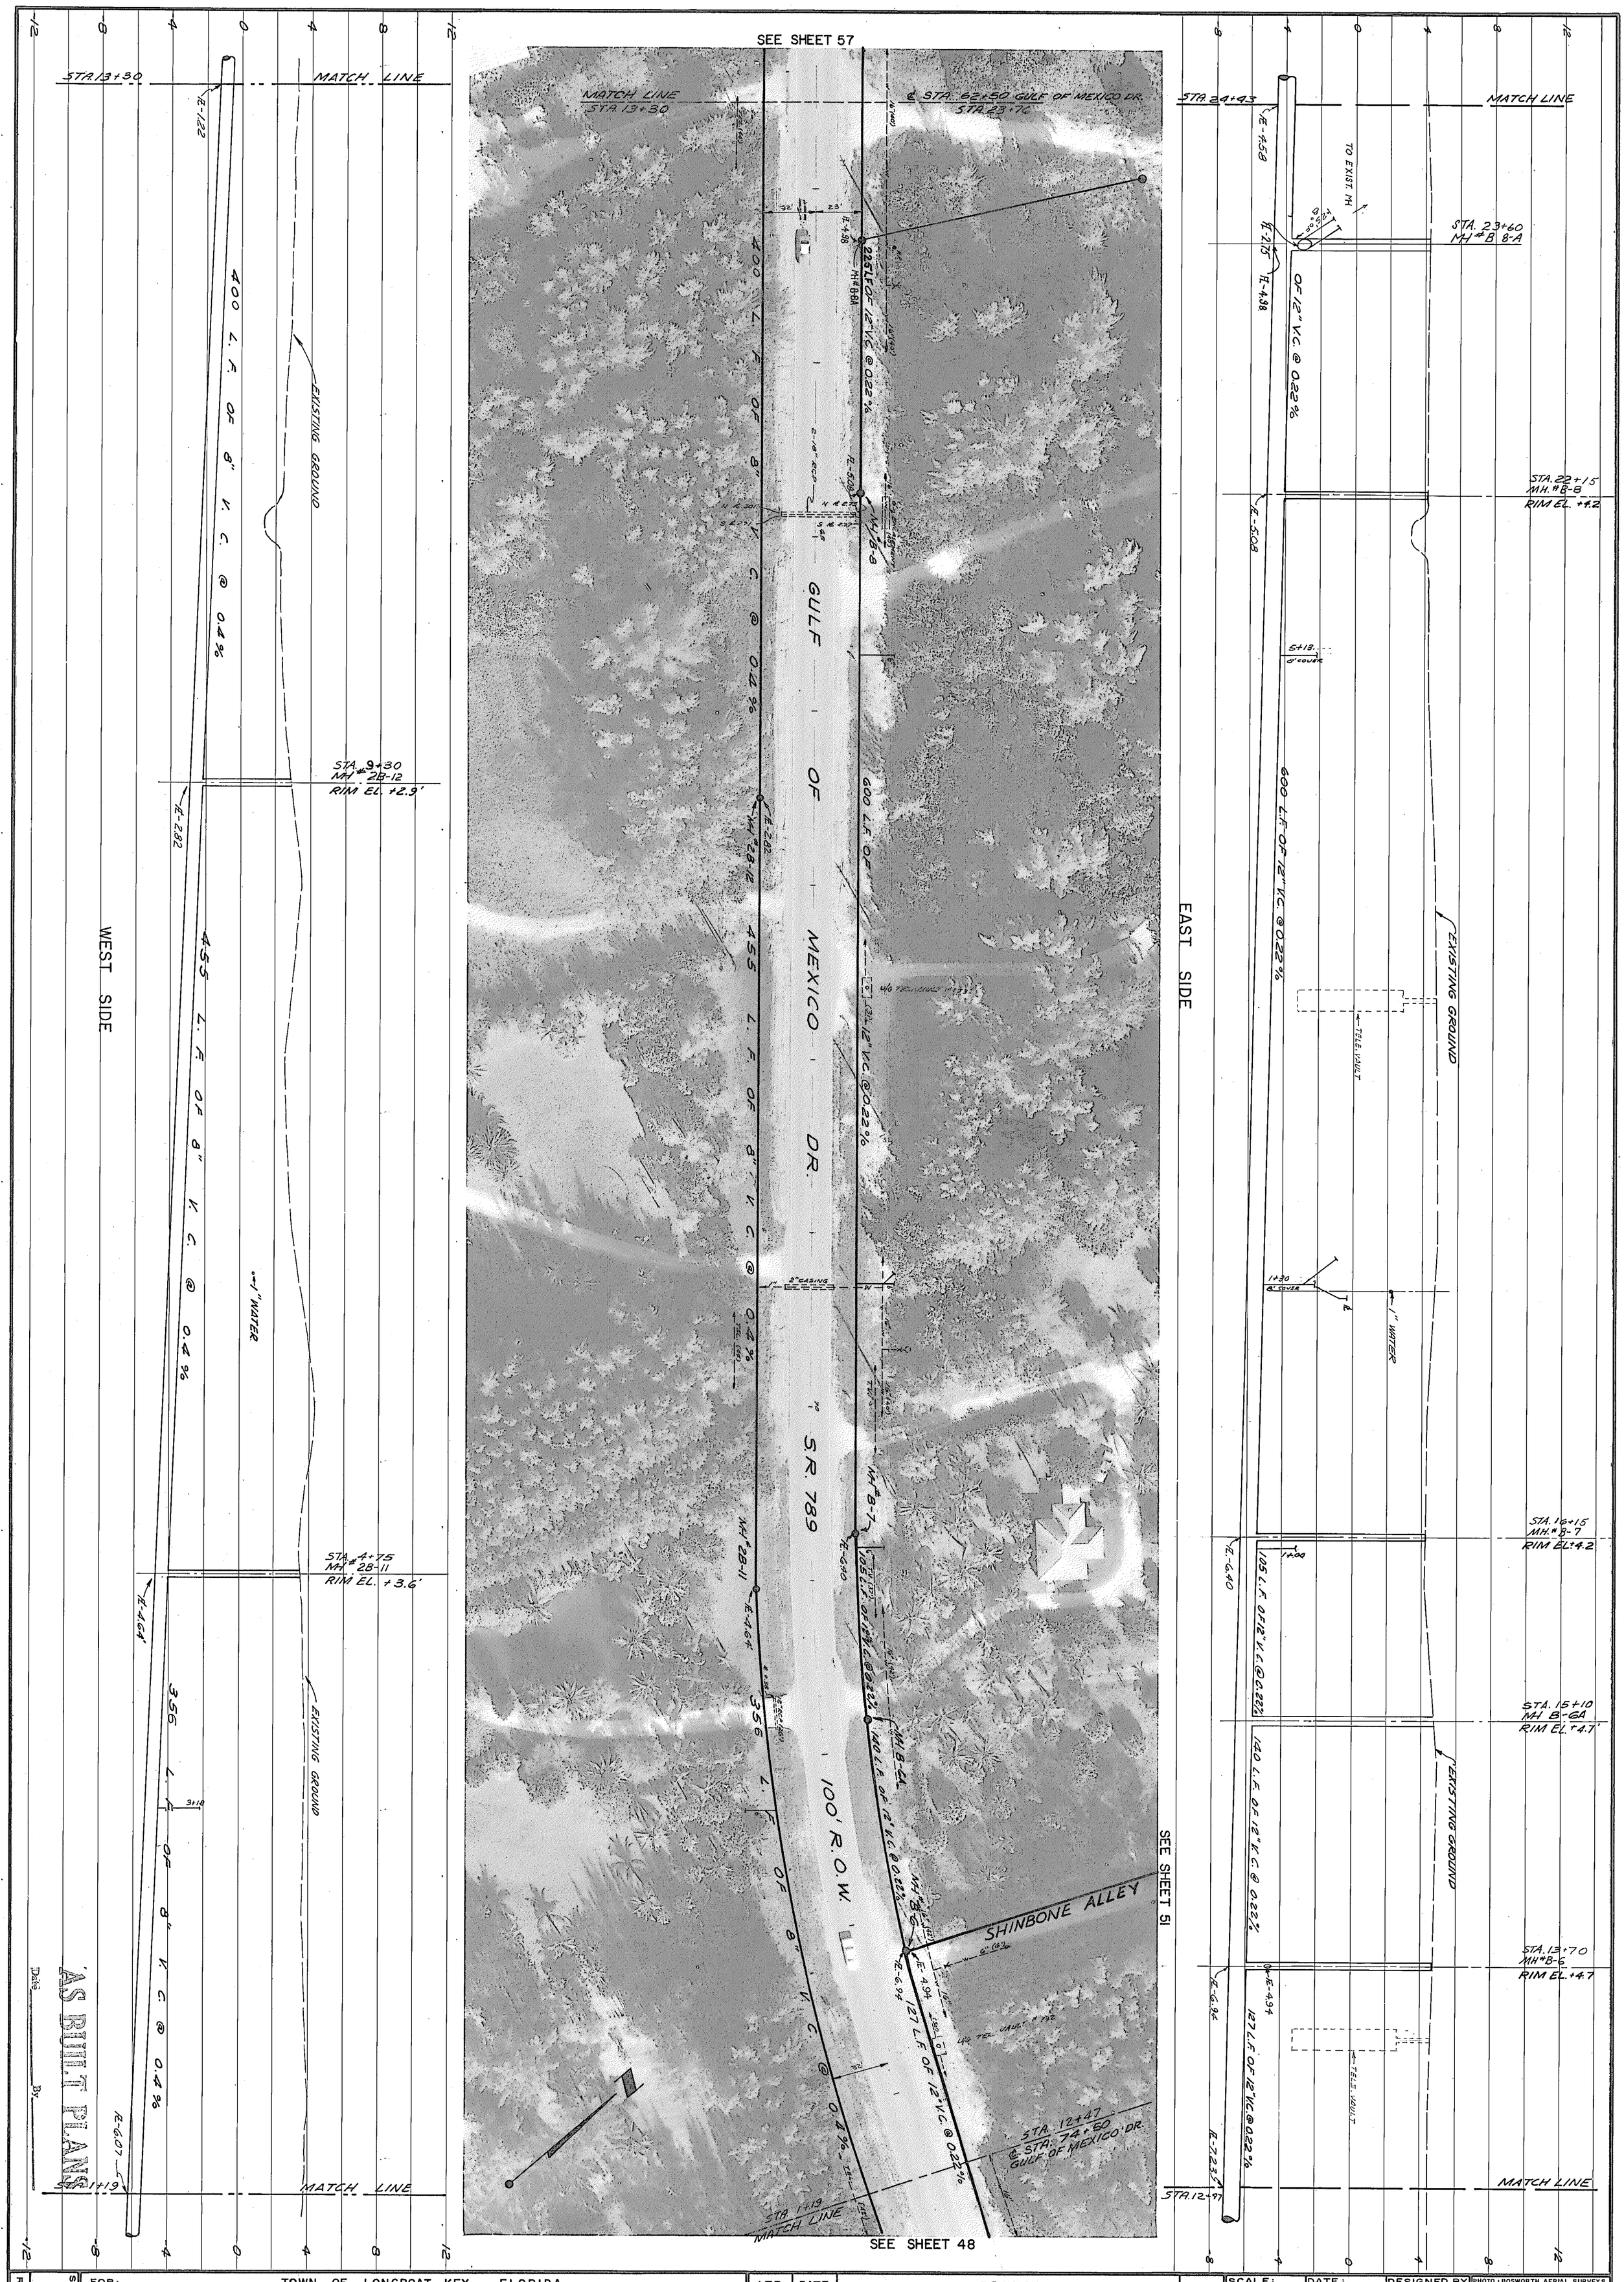

REVISION B	SHEET NUMBER 50	FOR: TOWN OF LONGBOAT KEY, FLORIDA GULF OF MEXICO DRIVE W. MH 2B-12 TO MH 2B-11, E. MH B-8 TO MH B-6 WASTEWATER COLLECTION SYSTEM	LTR. A B	DATE 5/16/74 8-21-75	REVISION AS BUILT ADDED MH B-6A	BY R.J.M. P.C.W.	SCALE: HORIZ. 1"=40' VERT. 1"=4'	DATE: 4-13-73
							DESIGNED BY J.D.W., E.W.N. L.D.L.	PHOTO: BOSWORTH AERIAL SURVEYS SEPT. 1972
							DRAWN BY P.C.W.	CHECKED BY J.G., M.W. E.C.
							PROJECT NO. 1217-S	APPROVED BY J DAVID WEAGE, P.E. FLORIDA CERT. NO. 13801

SMALLY, WELLFORD & NALVEN — CONSULTING ENGINEERS — SARASOTA, FLORIDA

INDEX NO. E-1217-254