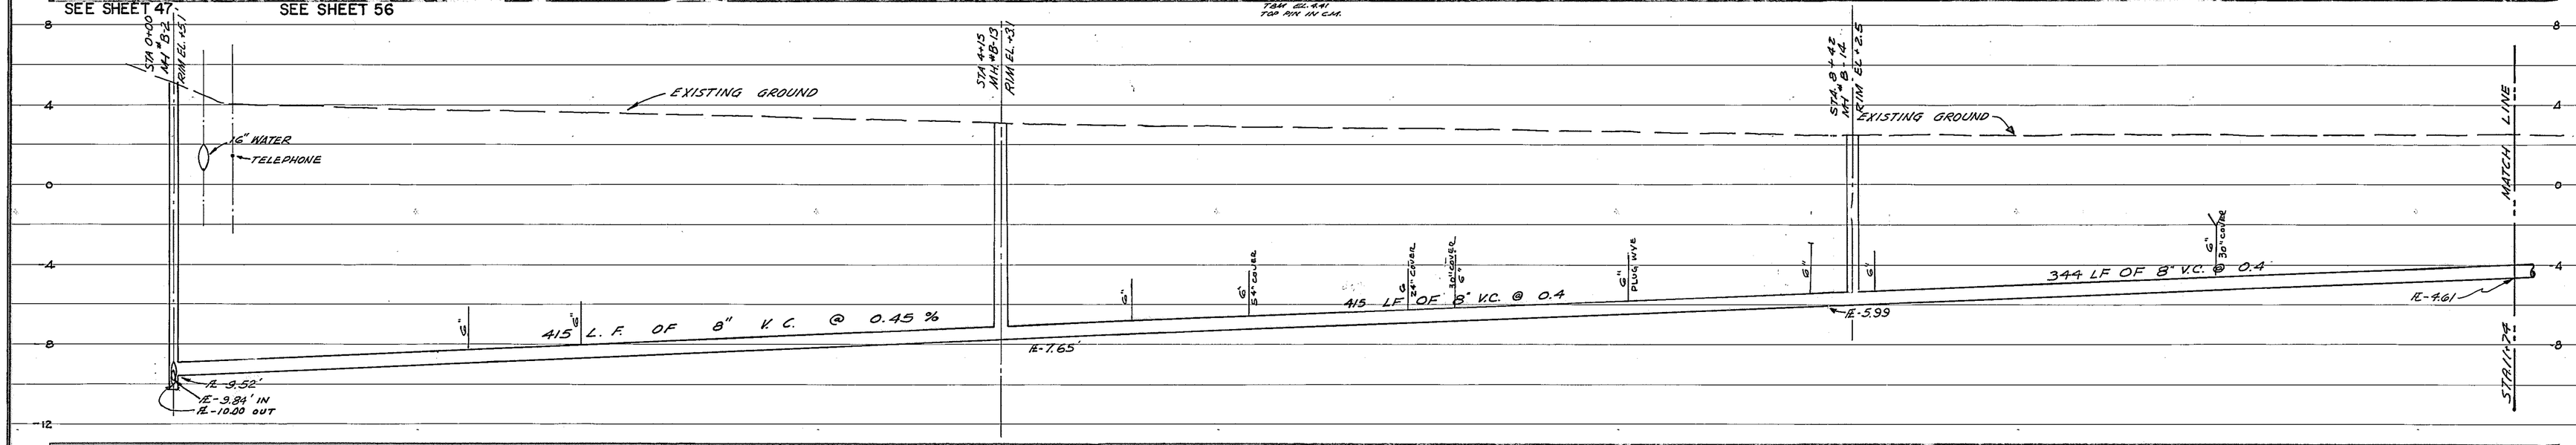

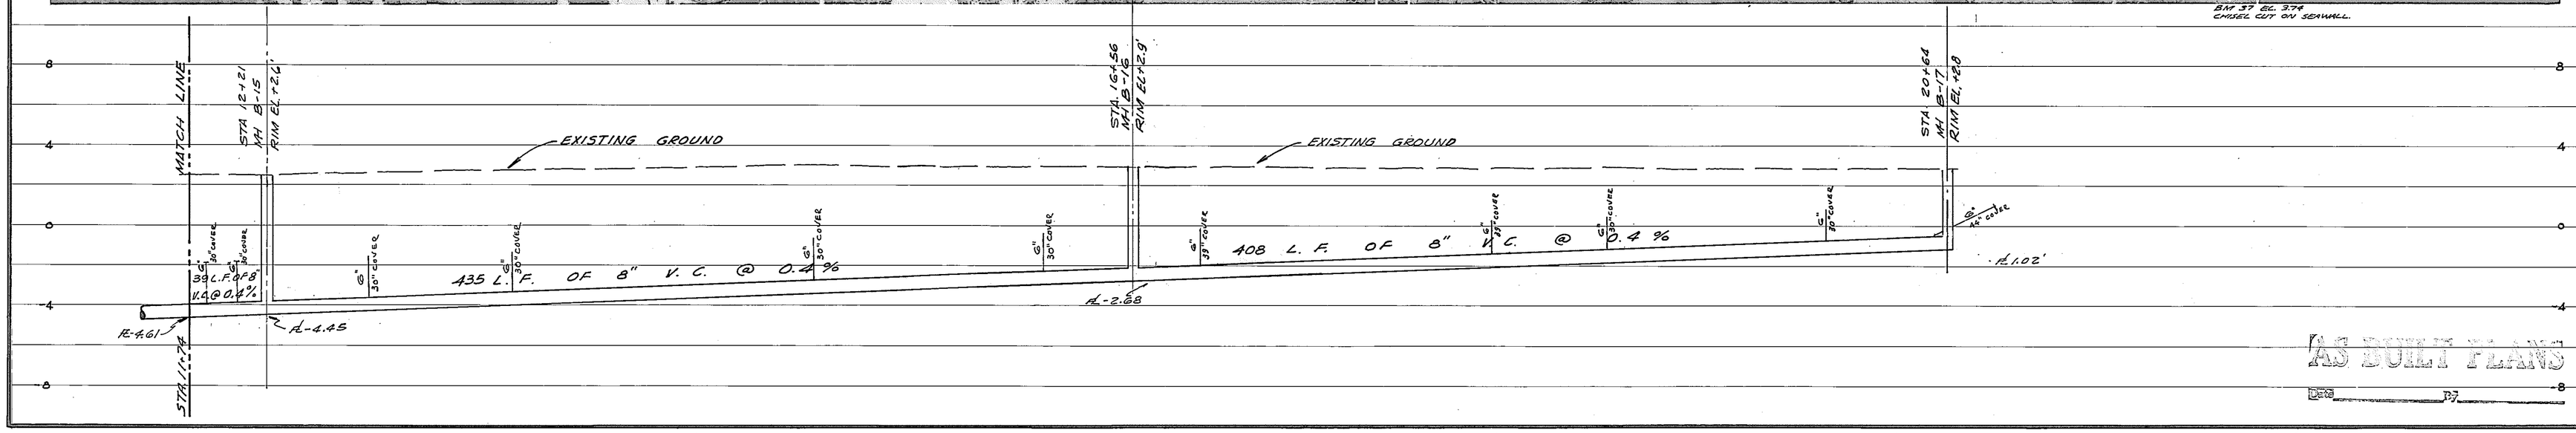

AS BUILT PLANS

PHOTO: BOSWORTH AERIAL SURVEYS	SEPT. 1972
APPROVED BY	
DESIGNED BY	JDW, EMN, L.D.L.
DATE:	4-13-73
PROJECT NO.	1217-S
SCALE: HORIZ. 1" = 40' VERT. 1" = 4'	
CHECKED BY	J.G., M.W., E.C.
DRAWN BY	P.C.W.
BY	F.C.K.
REVISION	RELOCATED MH B-15, MH B-16, MH B-17 & ADDED SERVICES.
DATE	8-21-75
LTR.	A
J. DAVID WEAKE, P.E. J. DAVID WEAKE, JR. P.E.	

SMALLY, WELLFORD & NALVEN — CONSULTING ENGINEERS — SARASOTA, FLORIDA

FOR: TOWN OF LONGBOAT KEY, FLORIDA

LYONS LANE

WASTEWATER COLLECTION SYSTEM

SHEET NUMBER 53

REVISION A

INDEX NO. E-1217-257