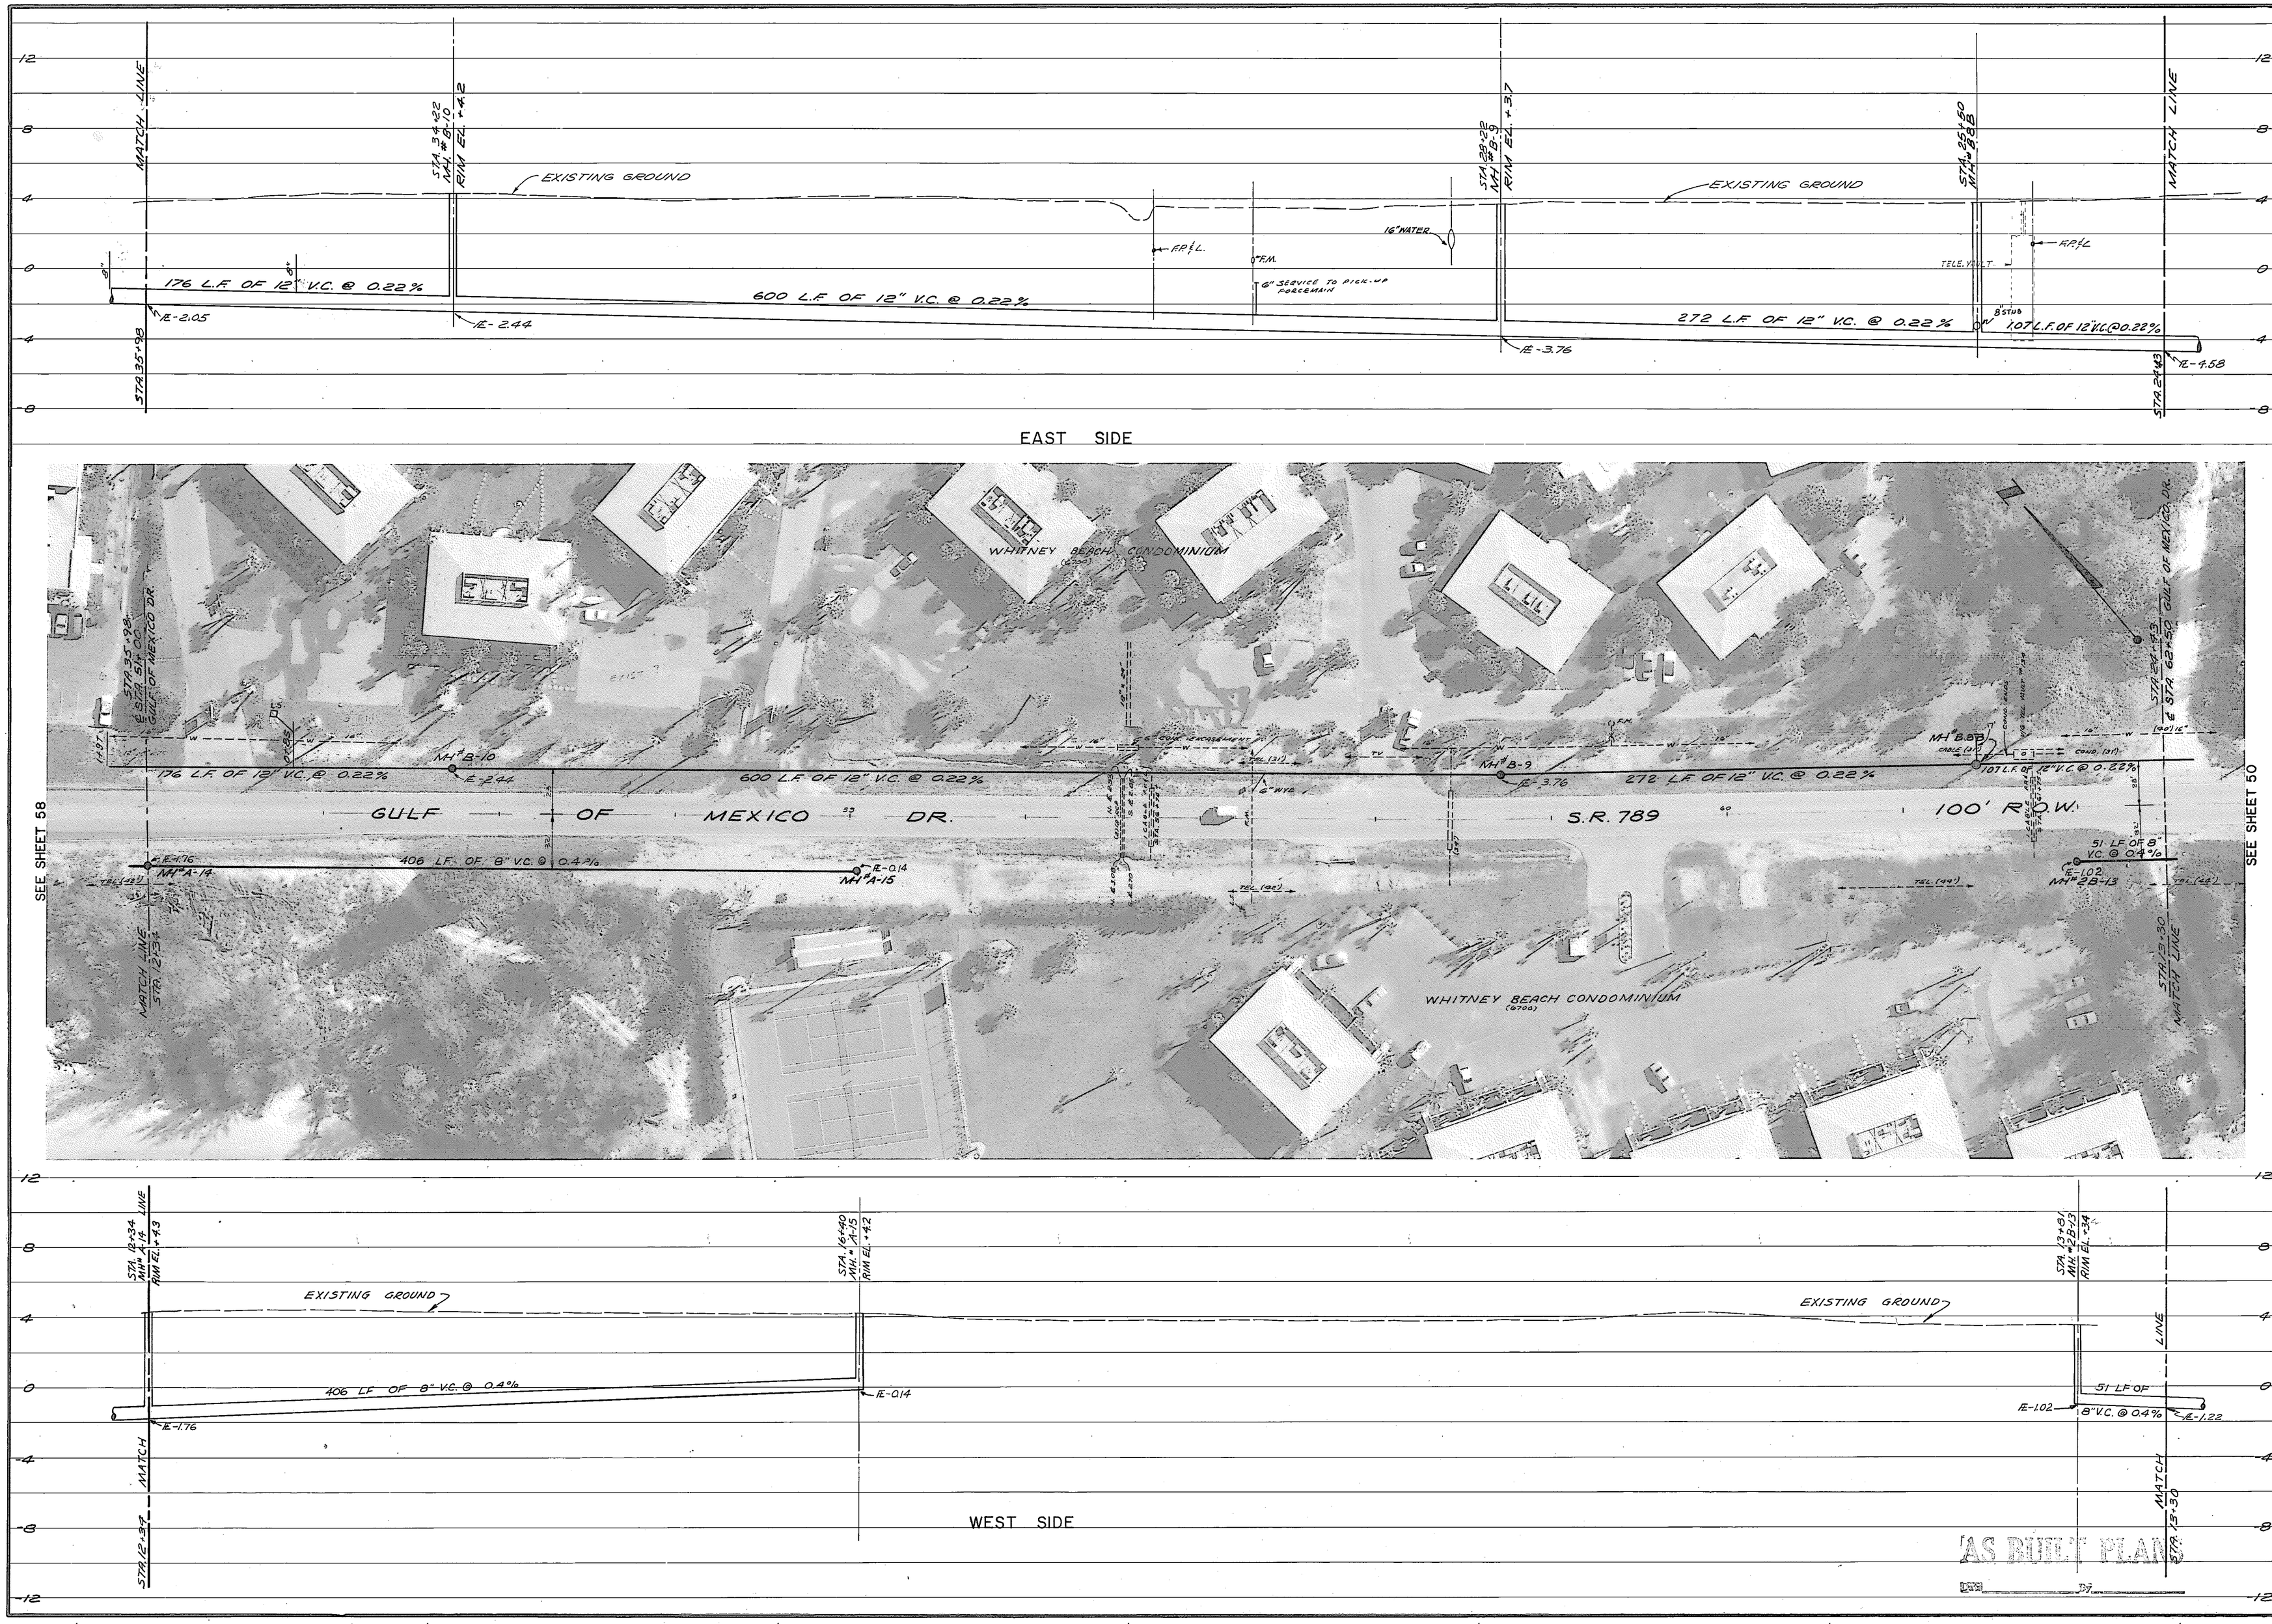

PHOTO - BISHOP'S AERIAL SURVEYS SEPT. 1972	APPROVED BY
DESIGNED BY J.D.A. L.A.C.	J. DAVID WEAGE - P.E. (FLORIDA CERT. NO. 13501)
DATE 4-13-73	PROJECT NO. 1217-S
SCALE HORIZ. 1"=40' VERT. 1"=4'	CHECKED BY J.G. M.W. E.C.
DRAWN BY S.L.K.	

BY	REVISION
P.C.M.	

LTR.	DATE	
"A"	8-19-74	AS BUILT

FOR: TOWN OF LONGBOAT KEY, FLORIDA

GULF OF MEXICO DRIVE
W. MH A-14 TO MH 2B-13, E. MH B-10 TO MH B-9
WASTEWATER COLLECTION SYSTEM

SMALLY, WELLFORD & NALVEN — CONSULTING ENGINEERS — SARASOTA, FLORIDA

SHEET NUMBER 57

REVISION "A"

INDEX NO. E-1217-261