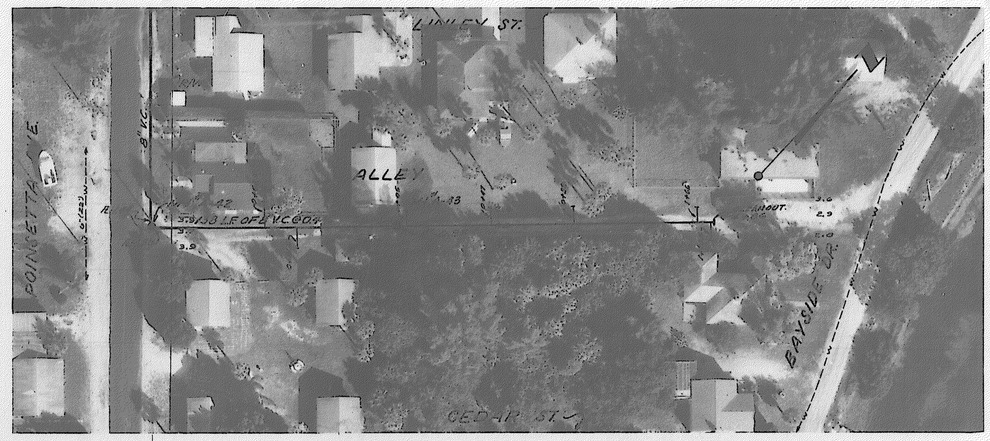


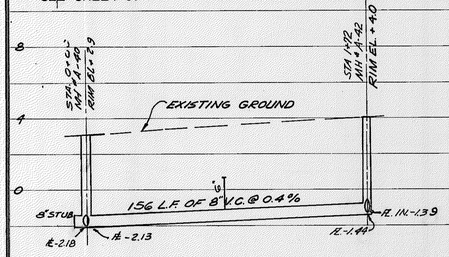


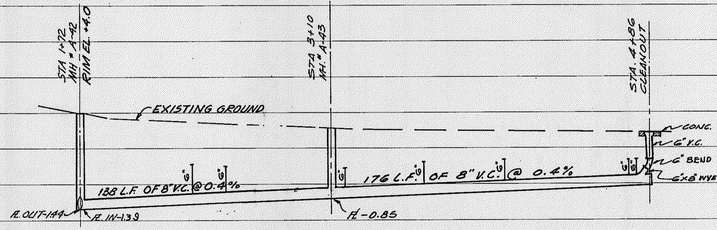


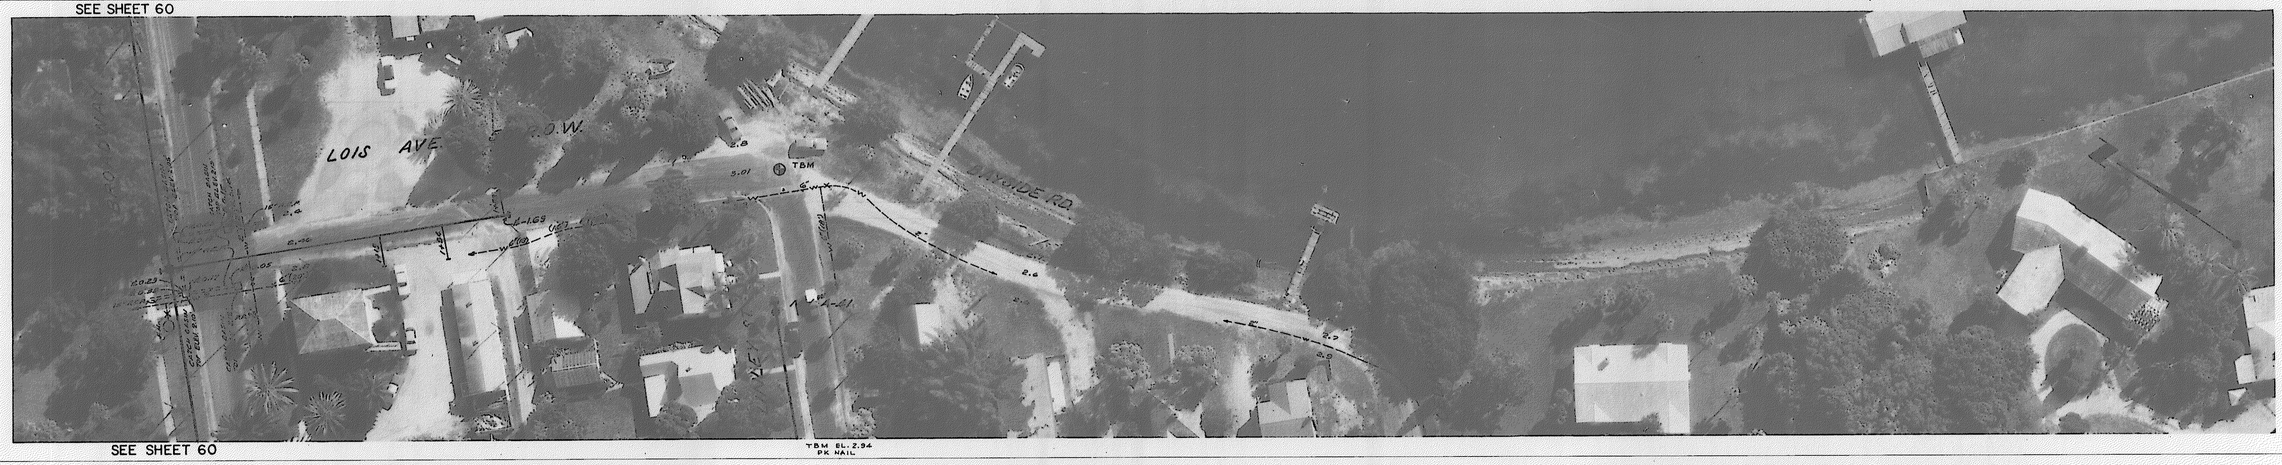


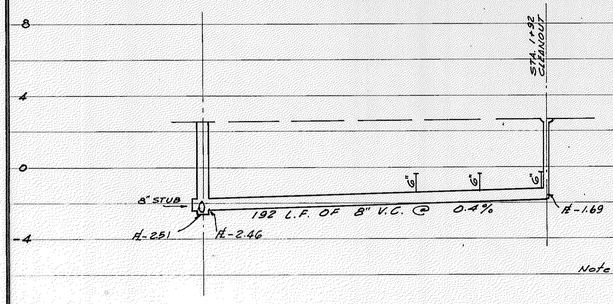


NO CONSTRUCTION

Note! THIS SECTION ADDED TO PICK-UP THESE HOUSES. O.K'D BY JOHN GROUT

AS BUILT PLANS

Date _____

| LTR. | DATE | REVISION | BY |
|---|---|---|---|
| A | 6-21-74 | AS BUILT | |
| B | 11-27-74 | JOHN GROUT ADDED 7 FLOWLINES | |

SCALE: HORIZ. 1"=40' VERT. 1"=4'
DATE: 4-13-73
DESIGNED BY J.W., E.W.H. C.D.L.
DRAWN BY
CHECKED BY J.G. J.W.W.
PROJECT NO. 1217-S
PHOTO: BOSWORTH AERIAL SURVEYS SEPT. 1972
APPROVED BY J. DAVID WEAGE, P.E. FLORIDA REG. NO. 13521

FOR: TOWN OF LONGBOAT KEY, FLORIDA

POINSETTA AVE., LOIS AVE., BAYSIDE RD., ALLEY
WASTEWATER COLLECTION SYSTEM

SMALLY, WELLFORD & NALVEN — CONSULTING ENGINEERS — SARASOTA, FLORIDA

SHEET NUMBER 68

REVISION B

INDEX NO. E-1217-272