


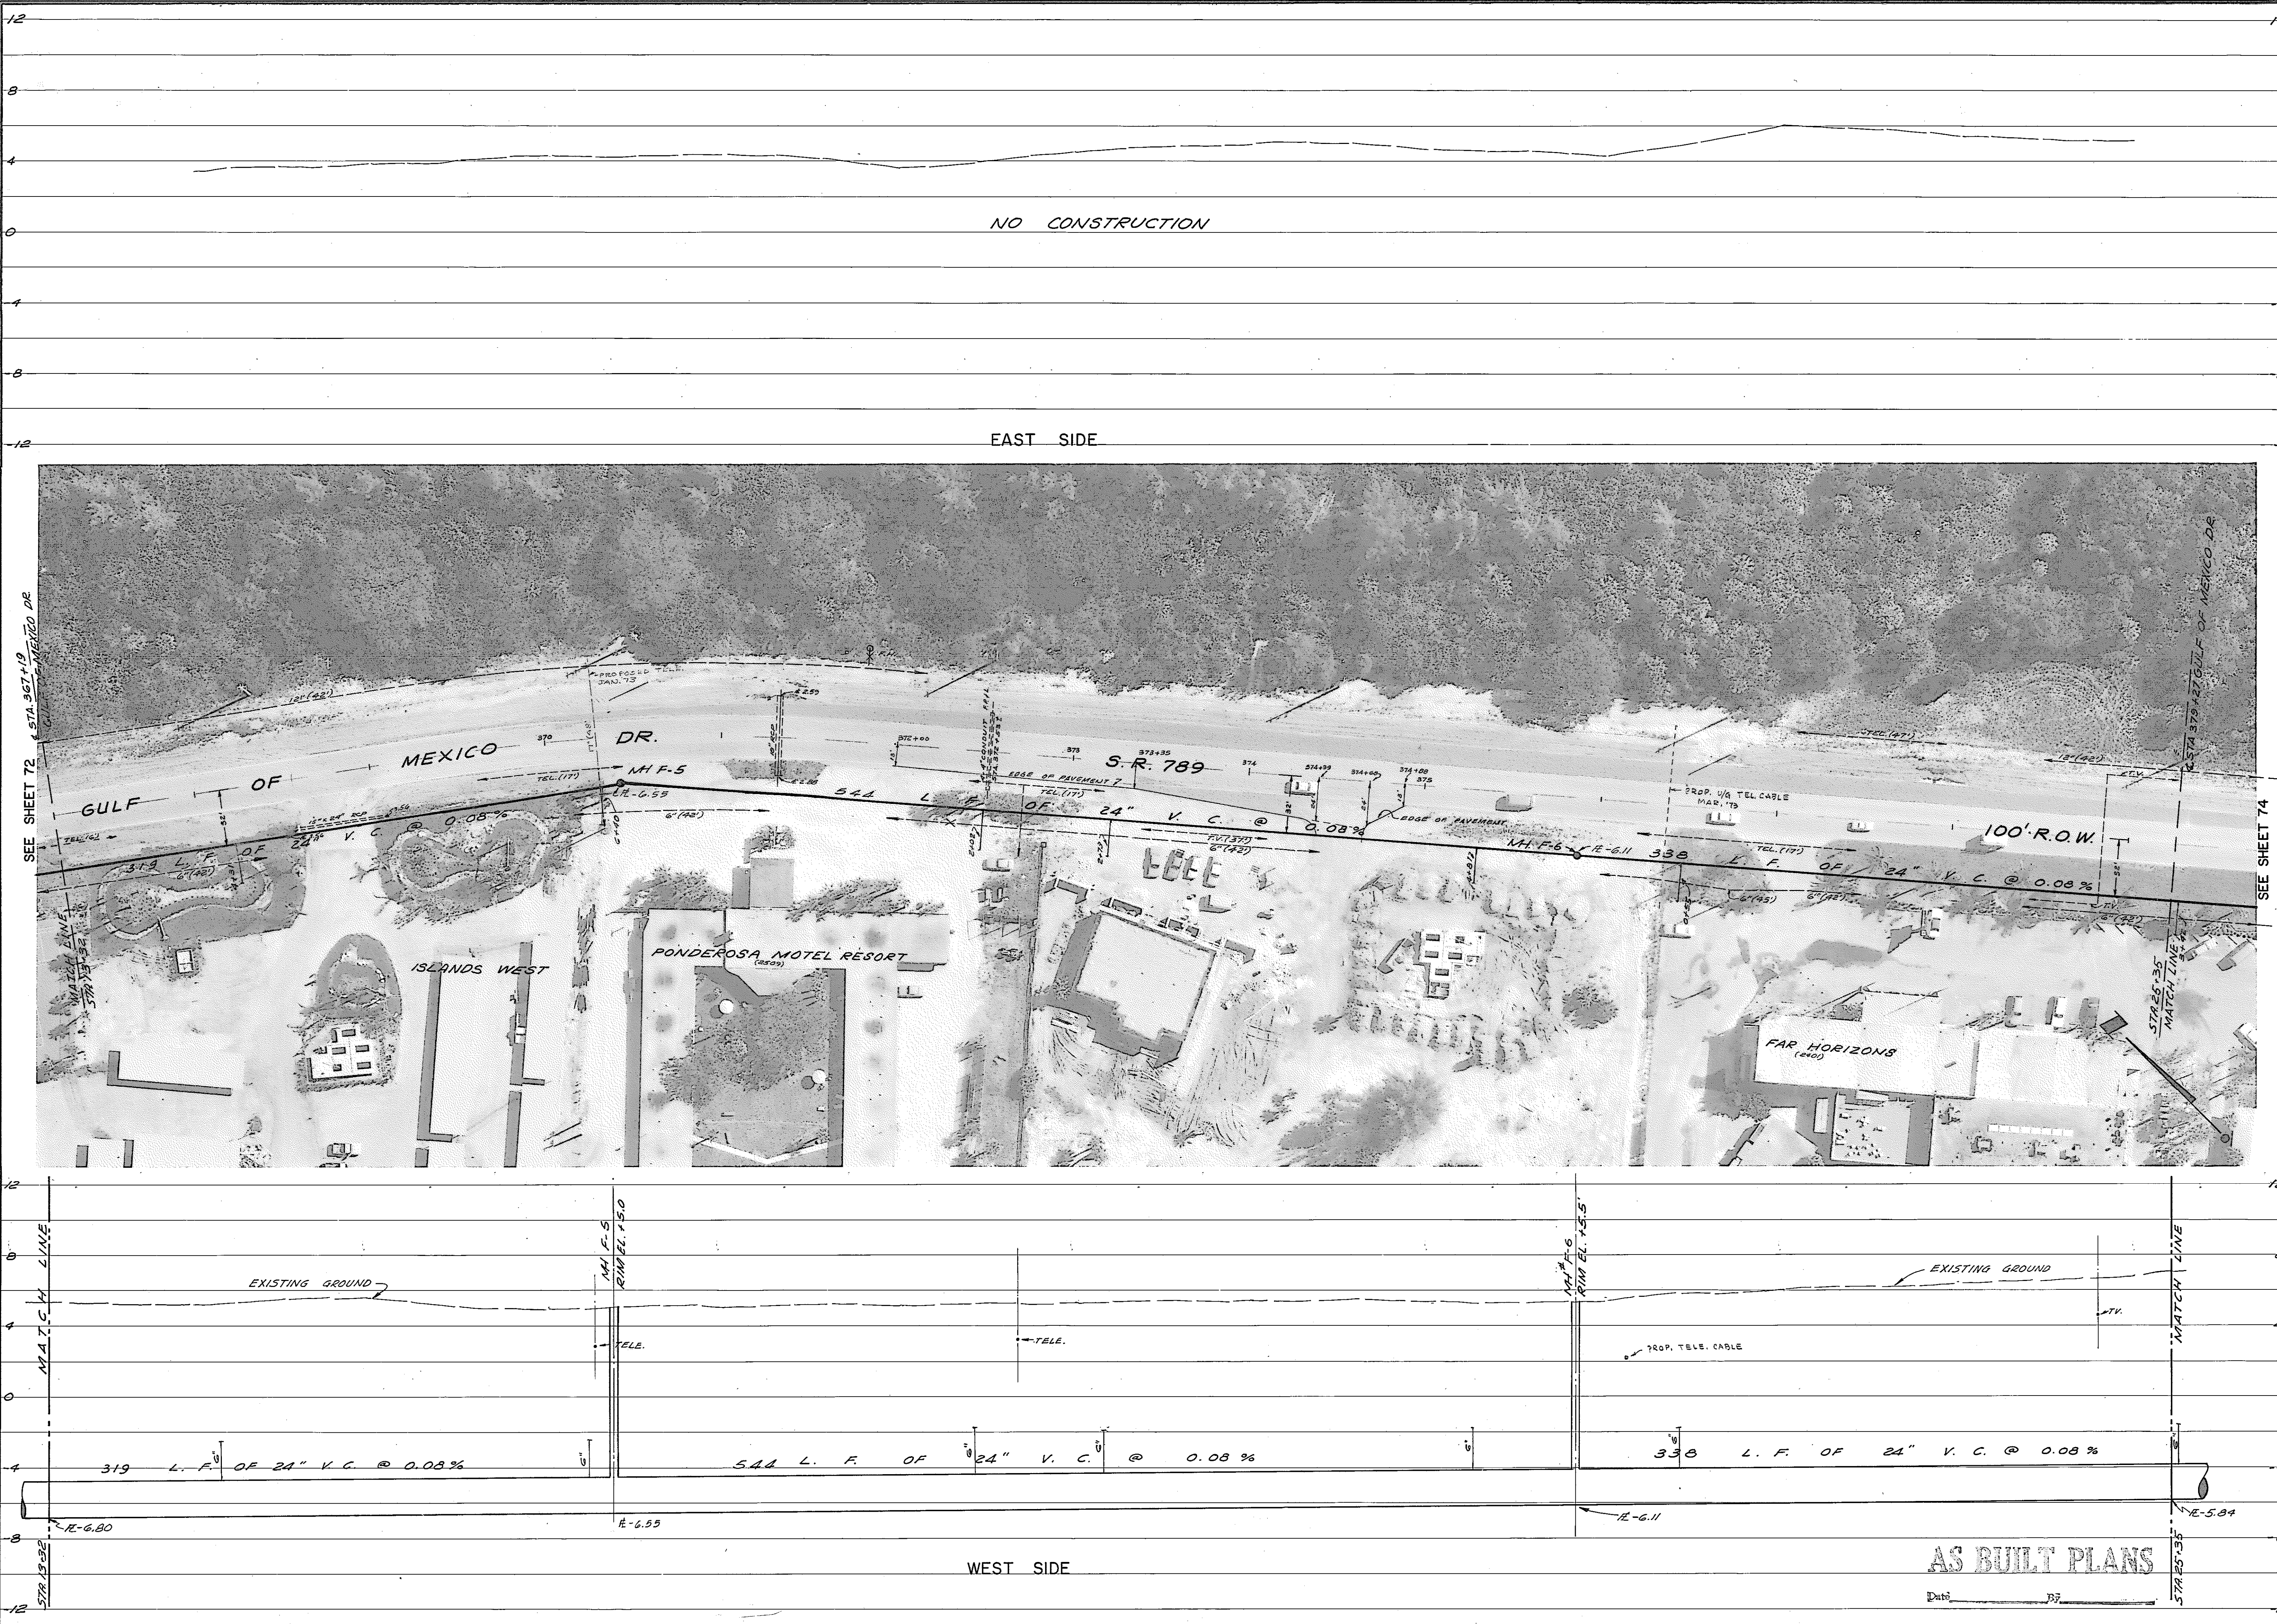

REVISION	SHEET NUMBER	FOR	DATE	BY	SCALE	DATE	DESIGNED BY	APPROVED BY
1	73	TOWN OF LONGBOAT KEY, FLORIDA	7-21-75	P.C.W.	HORIZ. 1"=40'	4-13-73	J.D.M./E.M.M.	SEPT. 1972
2		GULF OF MEXICO DRIVE	7-21-75	P.C.W.	VERT. 1"=4'		C.C.C.	
3		W. MH F-5 TO MH F-6						
4		WASTEWATER COLLECTION SYSTEM						
5		SMALLY, WELLFORD & NALVEN — CONSULTING ENGINEERS — SARASOTA, FLORIDA						
6		INDEX NO. E-1217-277						