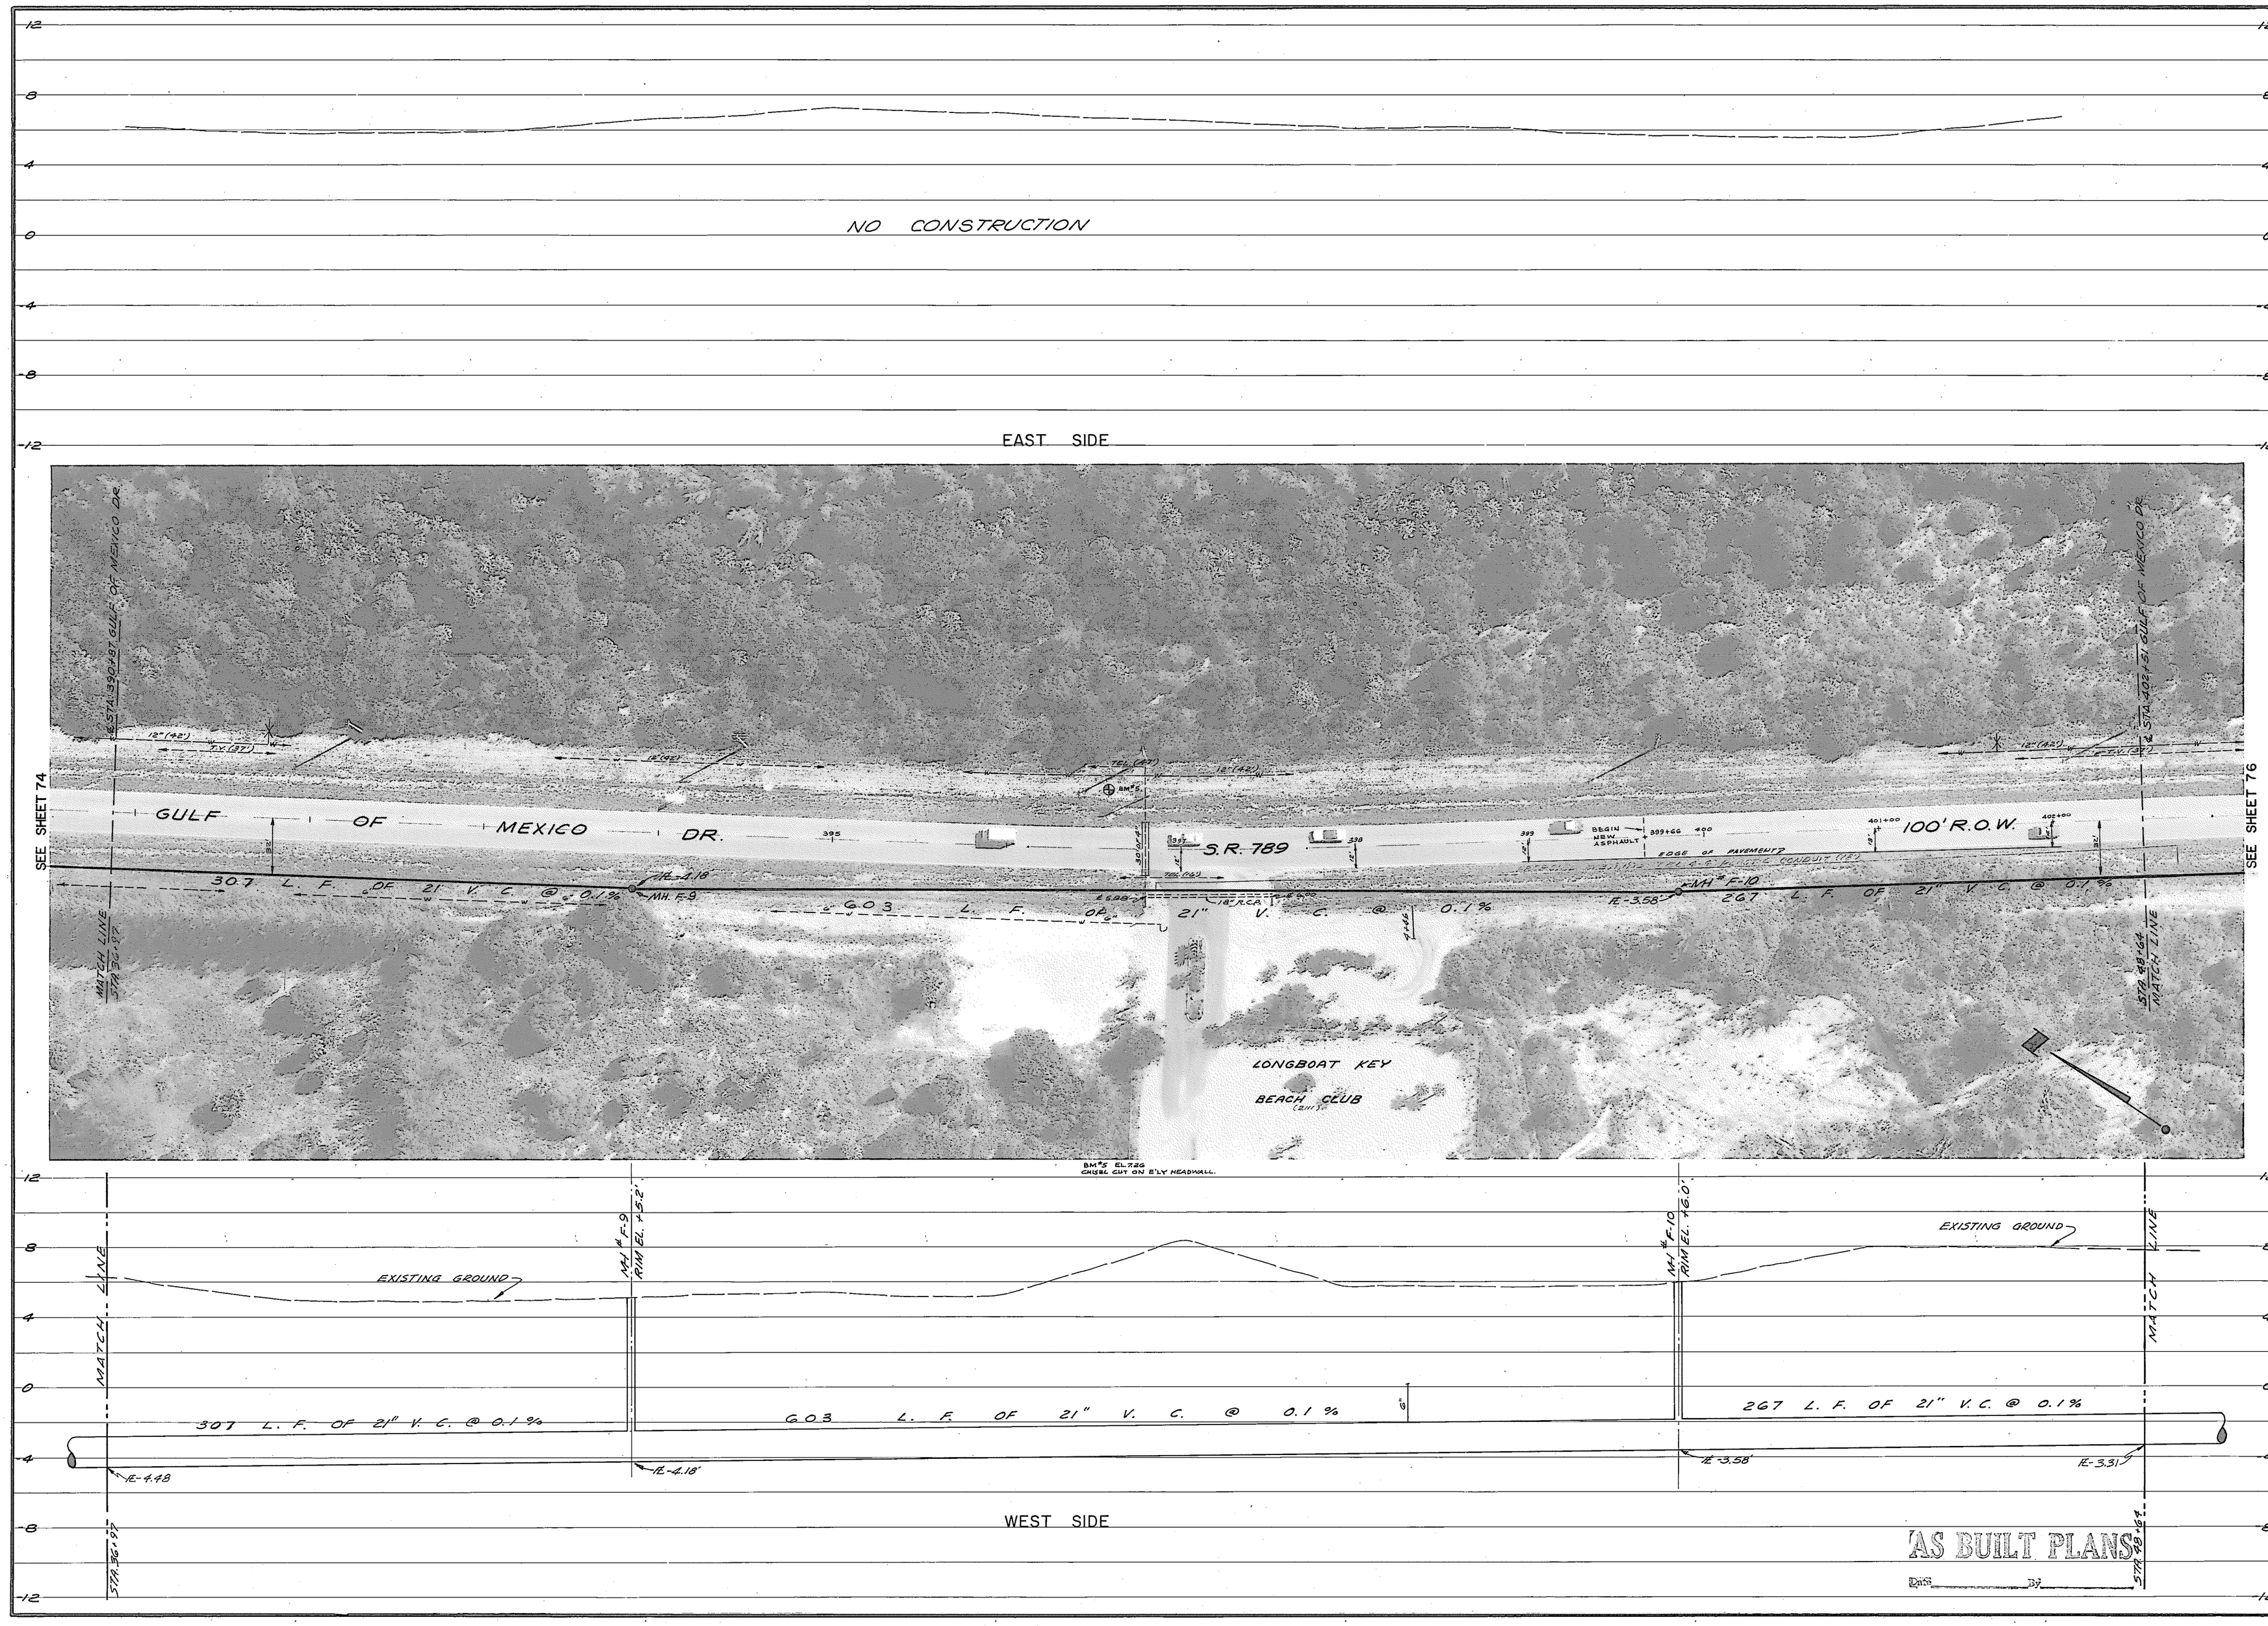

LTR.	DATE	REVISION	BY
A	7-3-74	NEW ROAD CONSTRUCTION	P.C.W.
B	7-31-74	MOVED SEWER LINE BETWEEN MH's F-10 AND F-11	P.C.W.
C	7-21-75	ADDED SEWER; INSTALLED CHANNEL BETWEEN MH F-10 AND MH F-11	

PHOTO - BOSWORTH AERIAL SURVEYS SEPT. 1972

APPROVED BY

J. DAVID WEAGE, P.E. FLORIDA REGIST. NO. 13601

DESIGNED BY	PROJECT NO.
J.D.M., E.M.W., L.D.C.	1217-S

SCALE:	DATE:	CHECKED BY
HORIZ. 1" = 40' VERT. 1" = 4'	4-13-73	J.D.M., E.M.W., L.D.C.

DRAWN BY: R.C.W.

FOR: TOWN OF LONGBOAT KEY, FLORIDA

GULF OF MEXICO DRIVE

W. MH F-9 TO MH F-10

WASTEWATER COLLECTION SYSTEM

SMALLY, WELLFORD & NALVEN — CONSULTING ENGINEERS — SARASOTA, FLORIDA

SHEET NUMBER 75

REVISION 'C'

INDEX NO. E-1217-279