INDEX NO. E-1217-280

SMALLY, WELLFORD & NALVEN — CONSULTING ENGINEERS — SARASOTA, FLORIDA

SHEET NUMBER	REVISION
76	'C'

FOR: TOWN OF LONGBOAT KEY, FLORIDA

GULF OF MEXICO DRIVE
W. MH F-11 TO MH F-12
WASTEWATER COLLECTION SYSTEM

LTR.	DATE	REVISION	BY
A	7.9.74	NEW ROAD CONSTRUCTION	P.C.N.
B	7.31.74	MOVED SEWER LINE BETWEEN MH'S F-10 AND F-12 MOVED MH F-11 5 FEET. CHANGED SEWER LINE ALIGNMENT BETWEEN MH F-12 & MH-13	P.C.N.
C	7.24.75	DISTANCE CHANGE BETWEEN MH F-11, MH F-12 AND MH F-13	

SCALE:	DRAWN BY	DESIGNED BY
HORIZ. 1"=40'		J.D.W., E.W.N.
VERT. 1"=4'		
DATE: 4-13-73	CHECKED BY J.G., M.W., E.C.	APPROVED BY L.O.L.
PROJECT NO. 1217-S		

PHOTO: BOSWORTH AERIAL SURVEYS SEPT. 1972
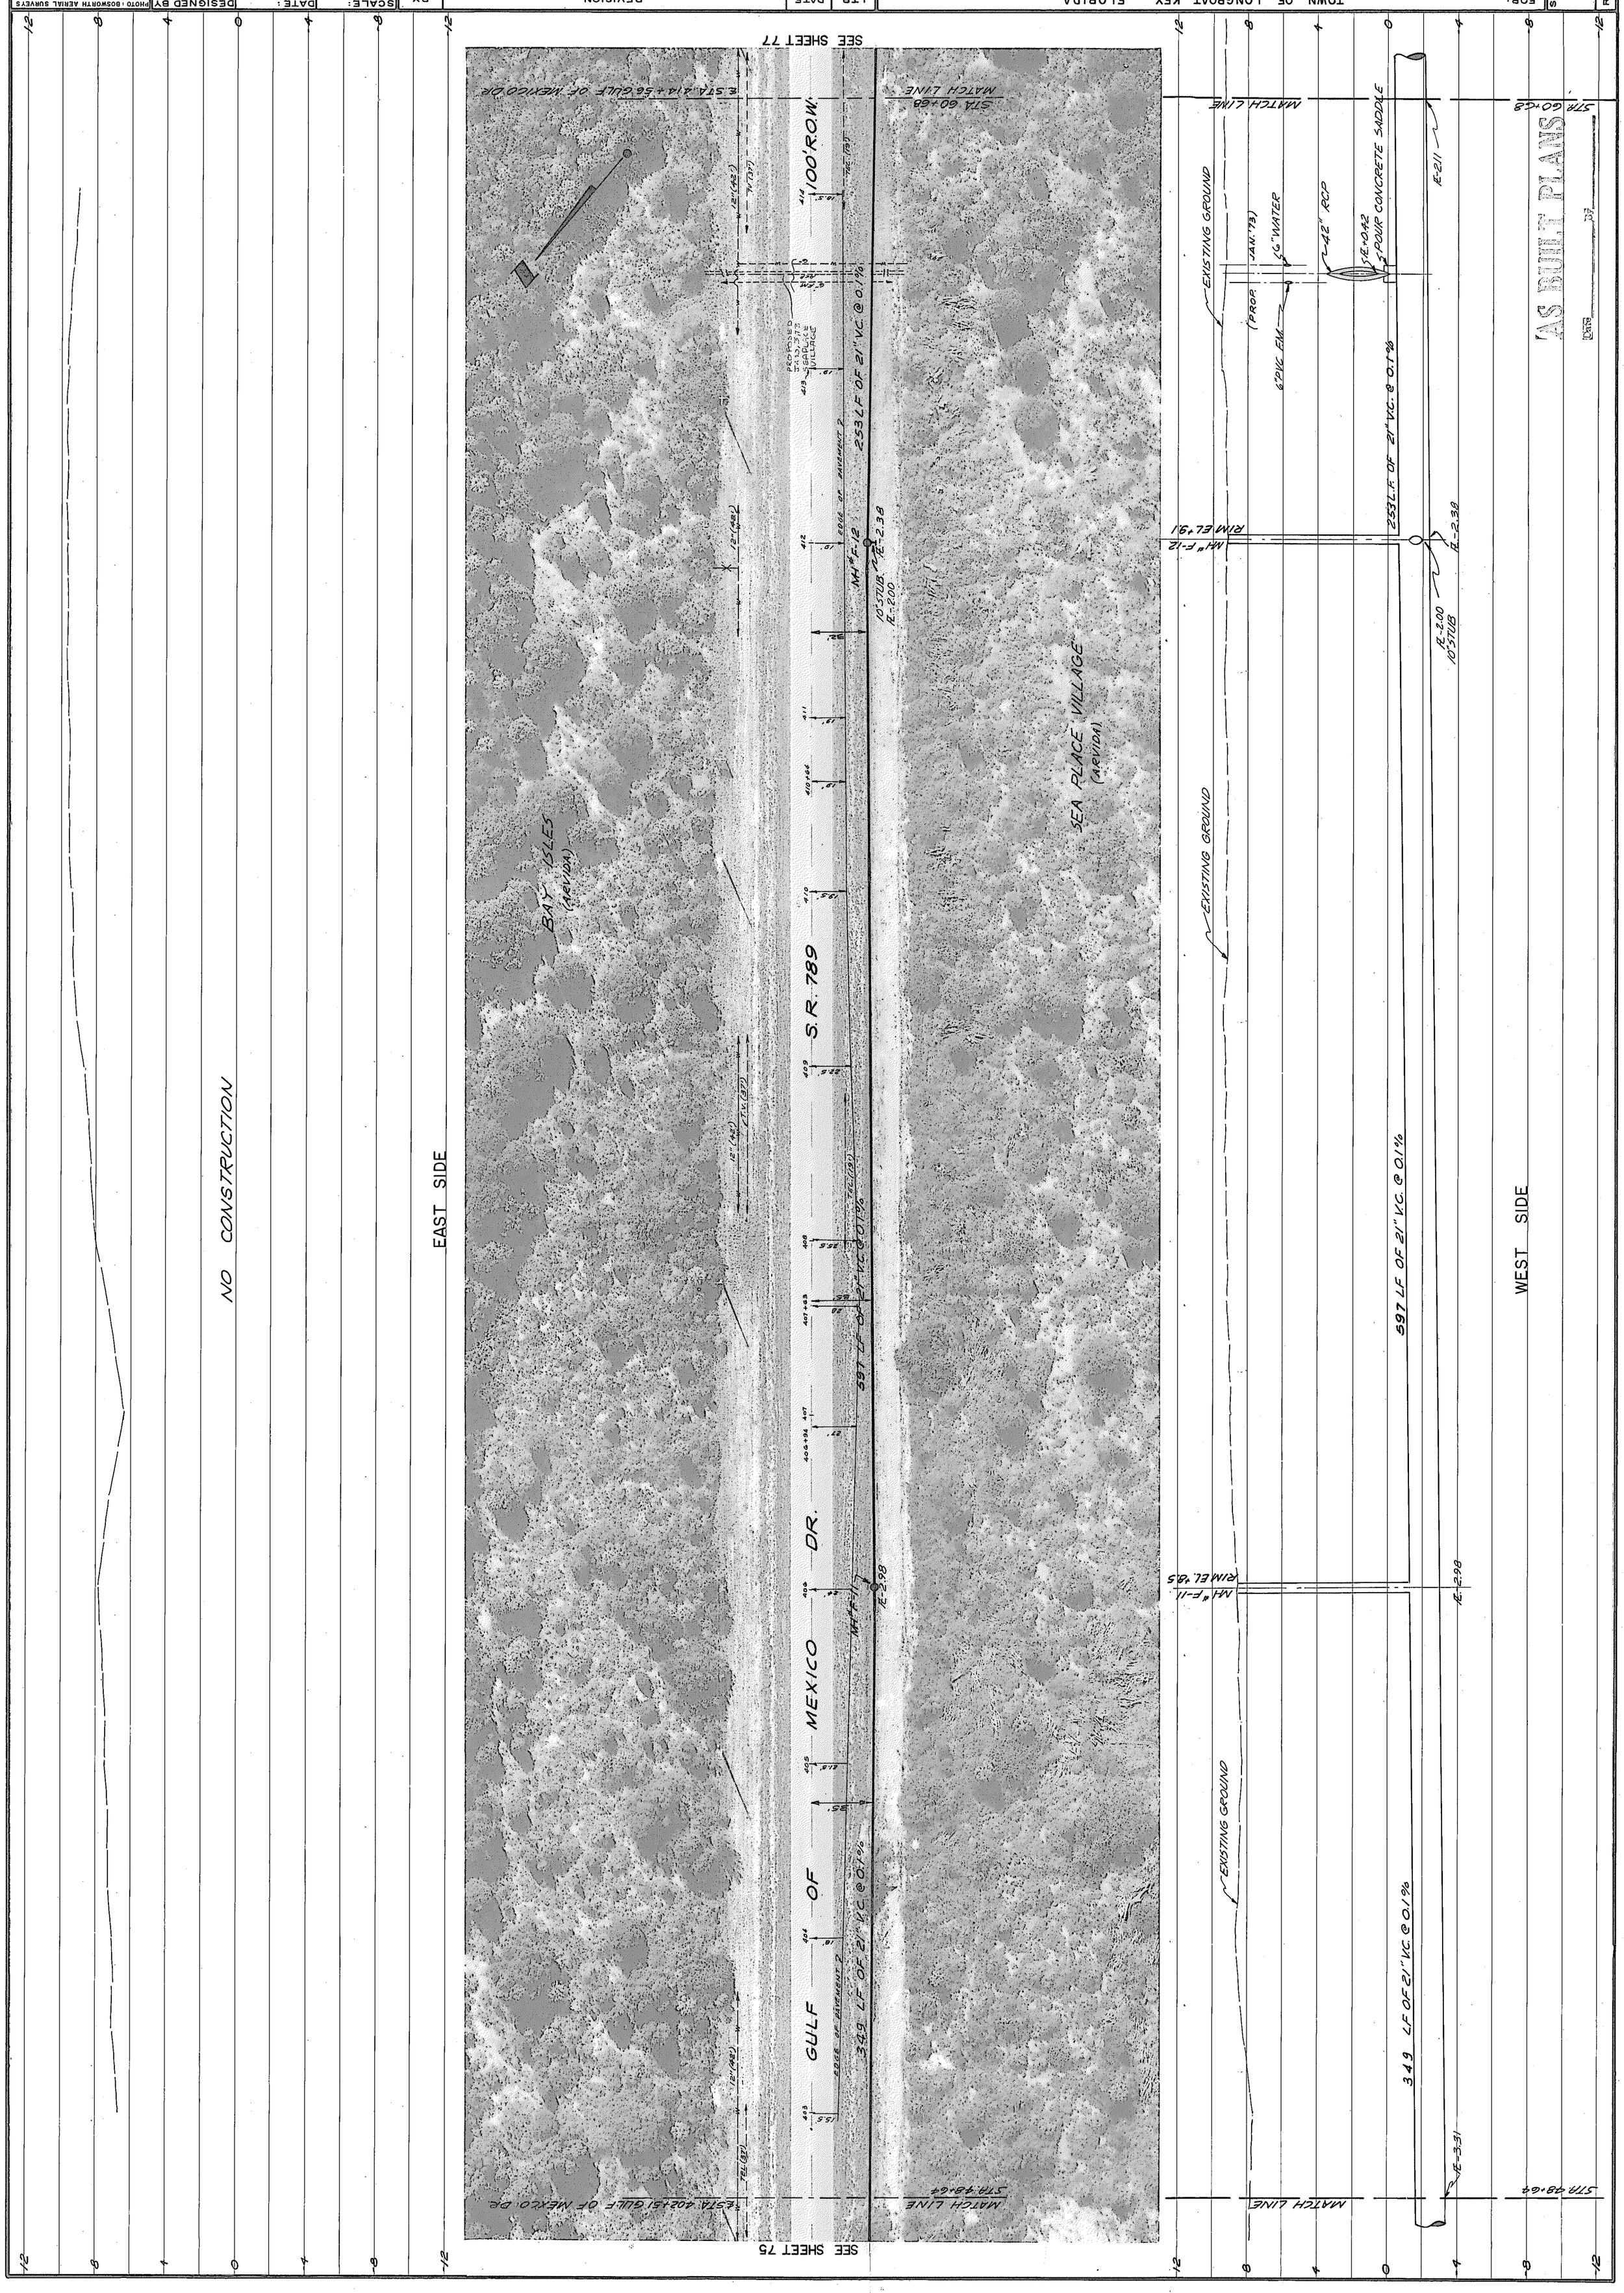
J. DAVID WEAGE, P.E. FLORIDA CERT. NO. 13801