


TOWN OF LONGBOAT KEY, FLORIDA
HALYARD LANE, BOGEY LANE
WASTEWATER COLLECTION SYSTEM

BY	DATE	SCALE	DESIGNED BY
PCW	4-13-73	HORIZ. 1"=40'	JDM, EMM
APPROVED BY		VERT. 1"=4'	L.D.L.
		CHECKED BY	PROJECT NO.
		U.S. MK	1217-S
		PCW	J. DAVID WEAVER, P.E.

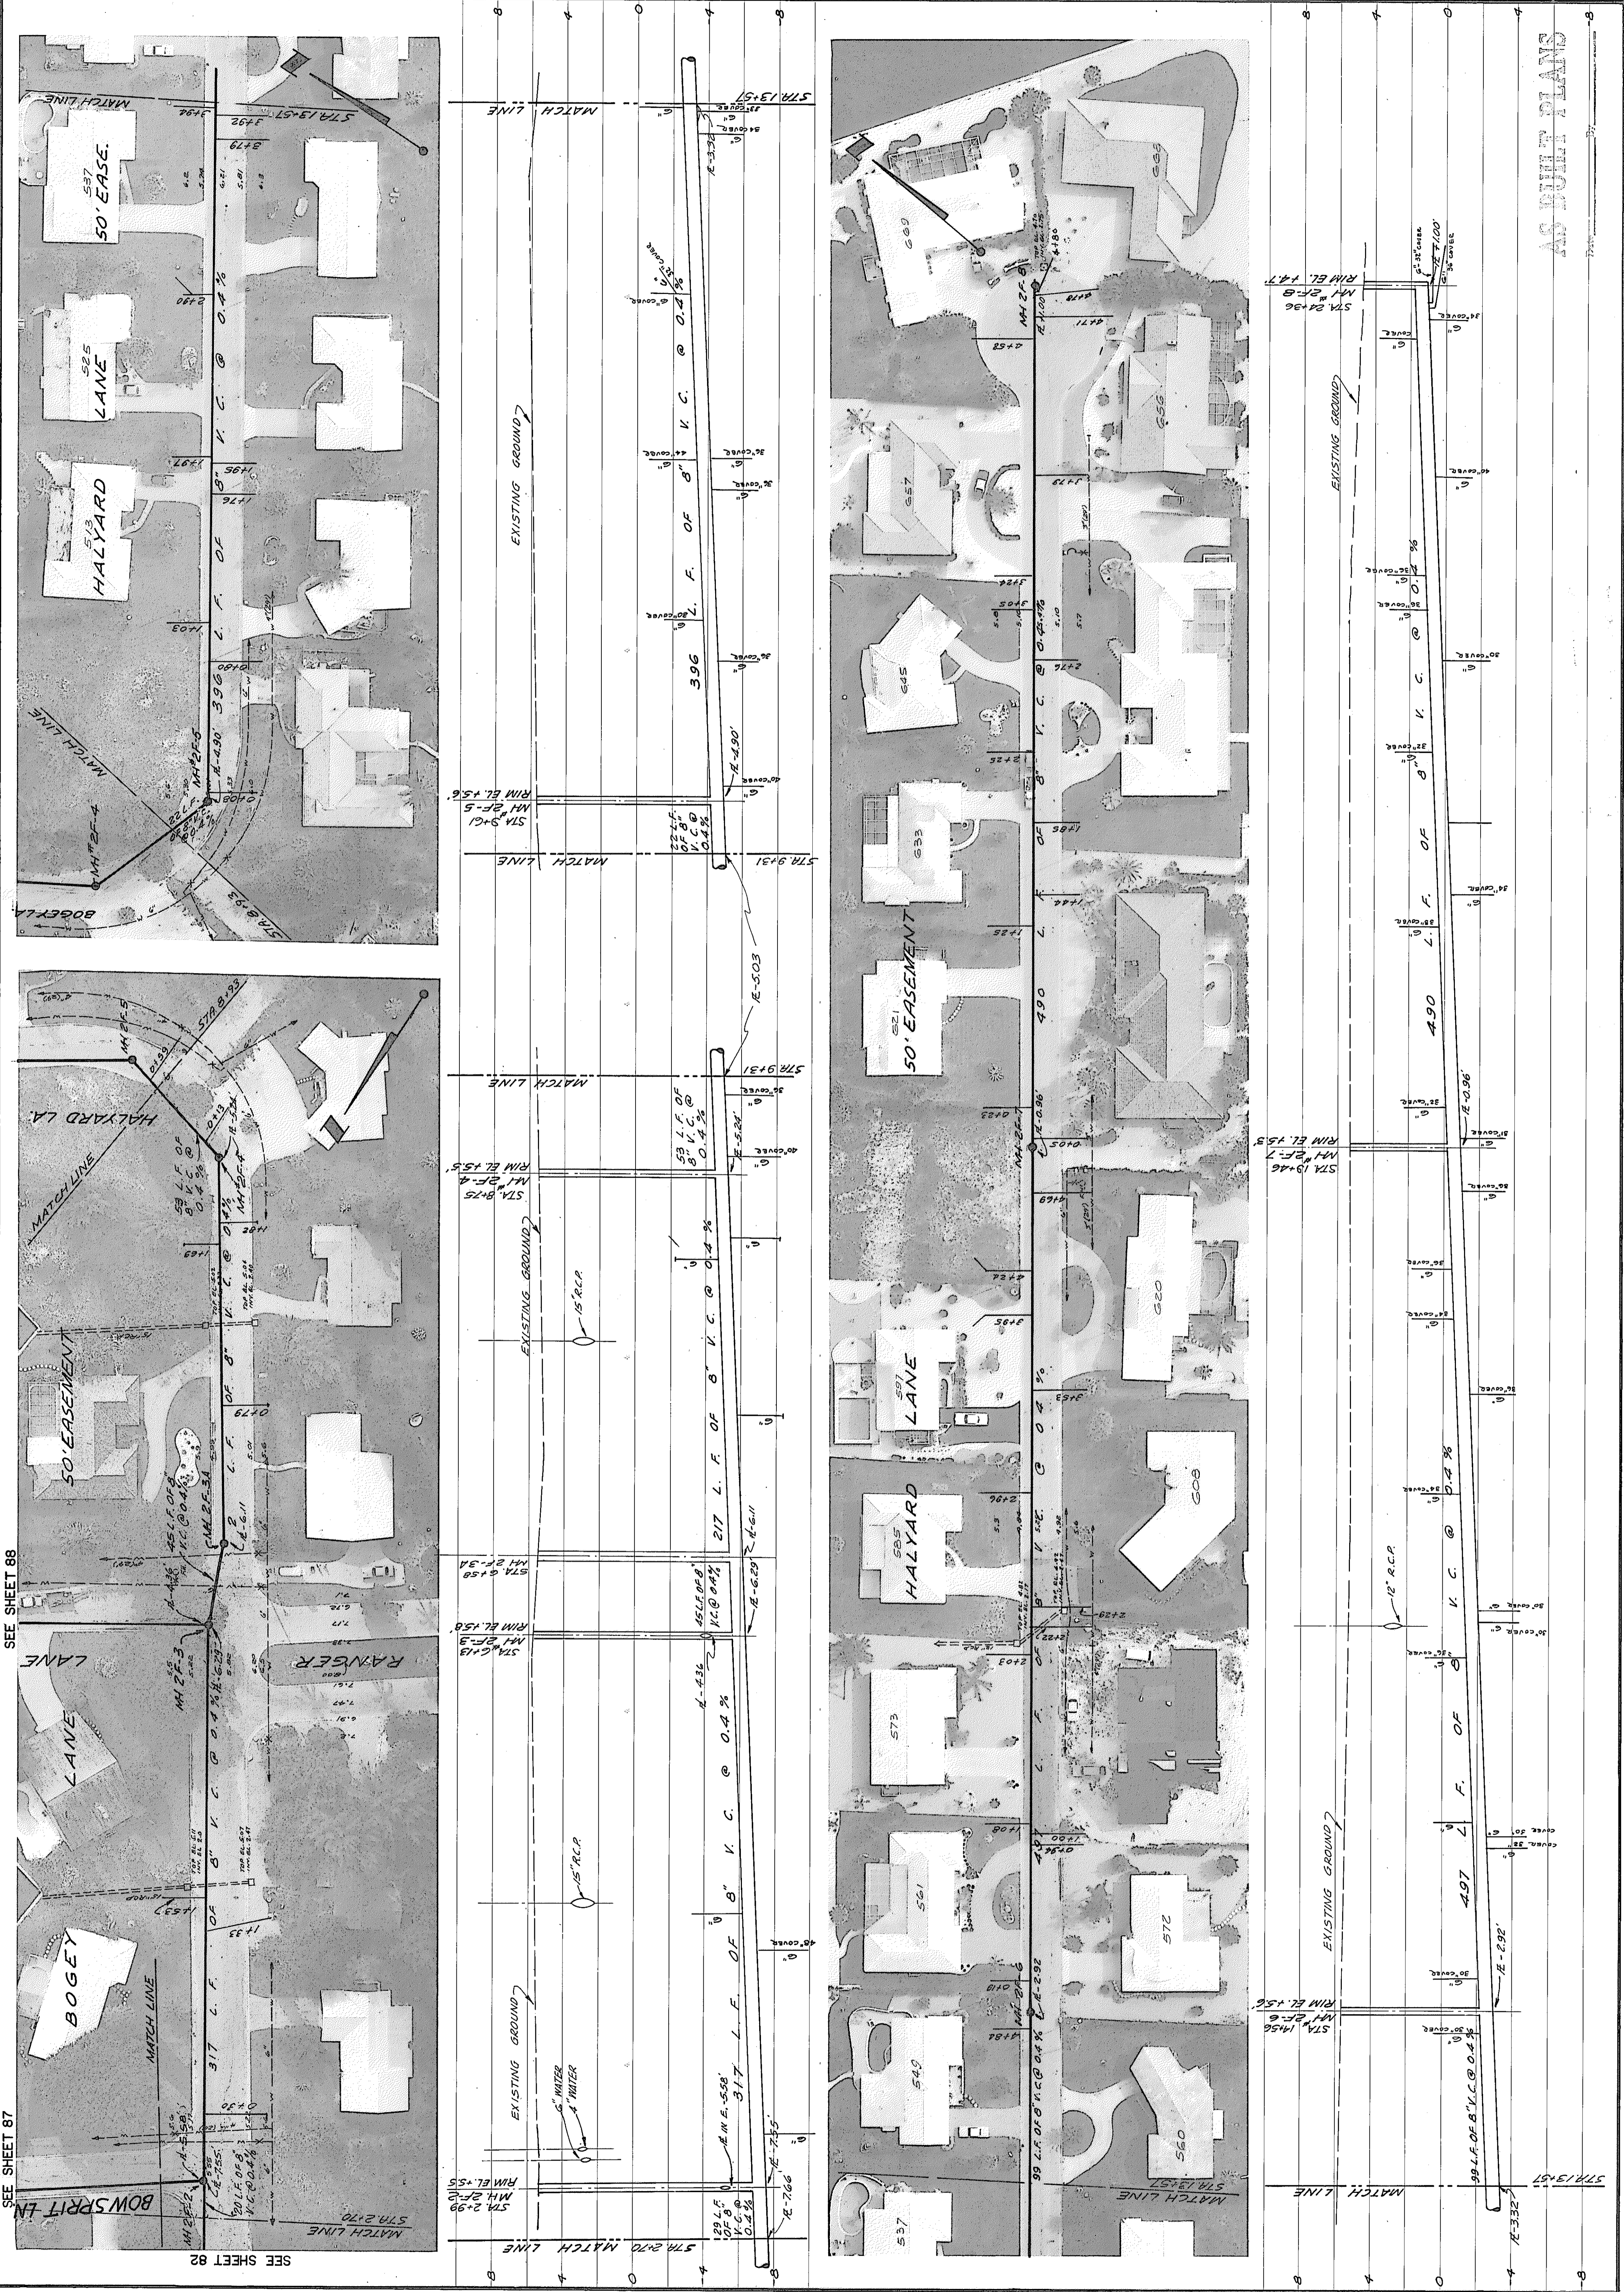

SEE SHEET 87

SEE SHEET 82

SEE SHEET 88

SEE SHEET 89