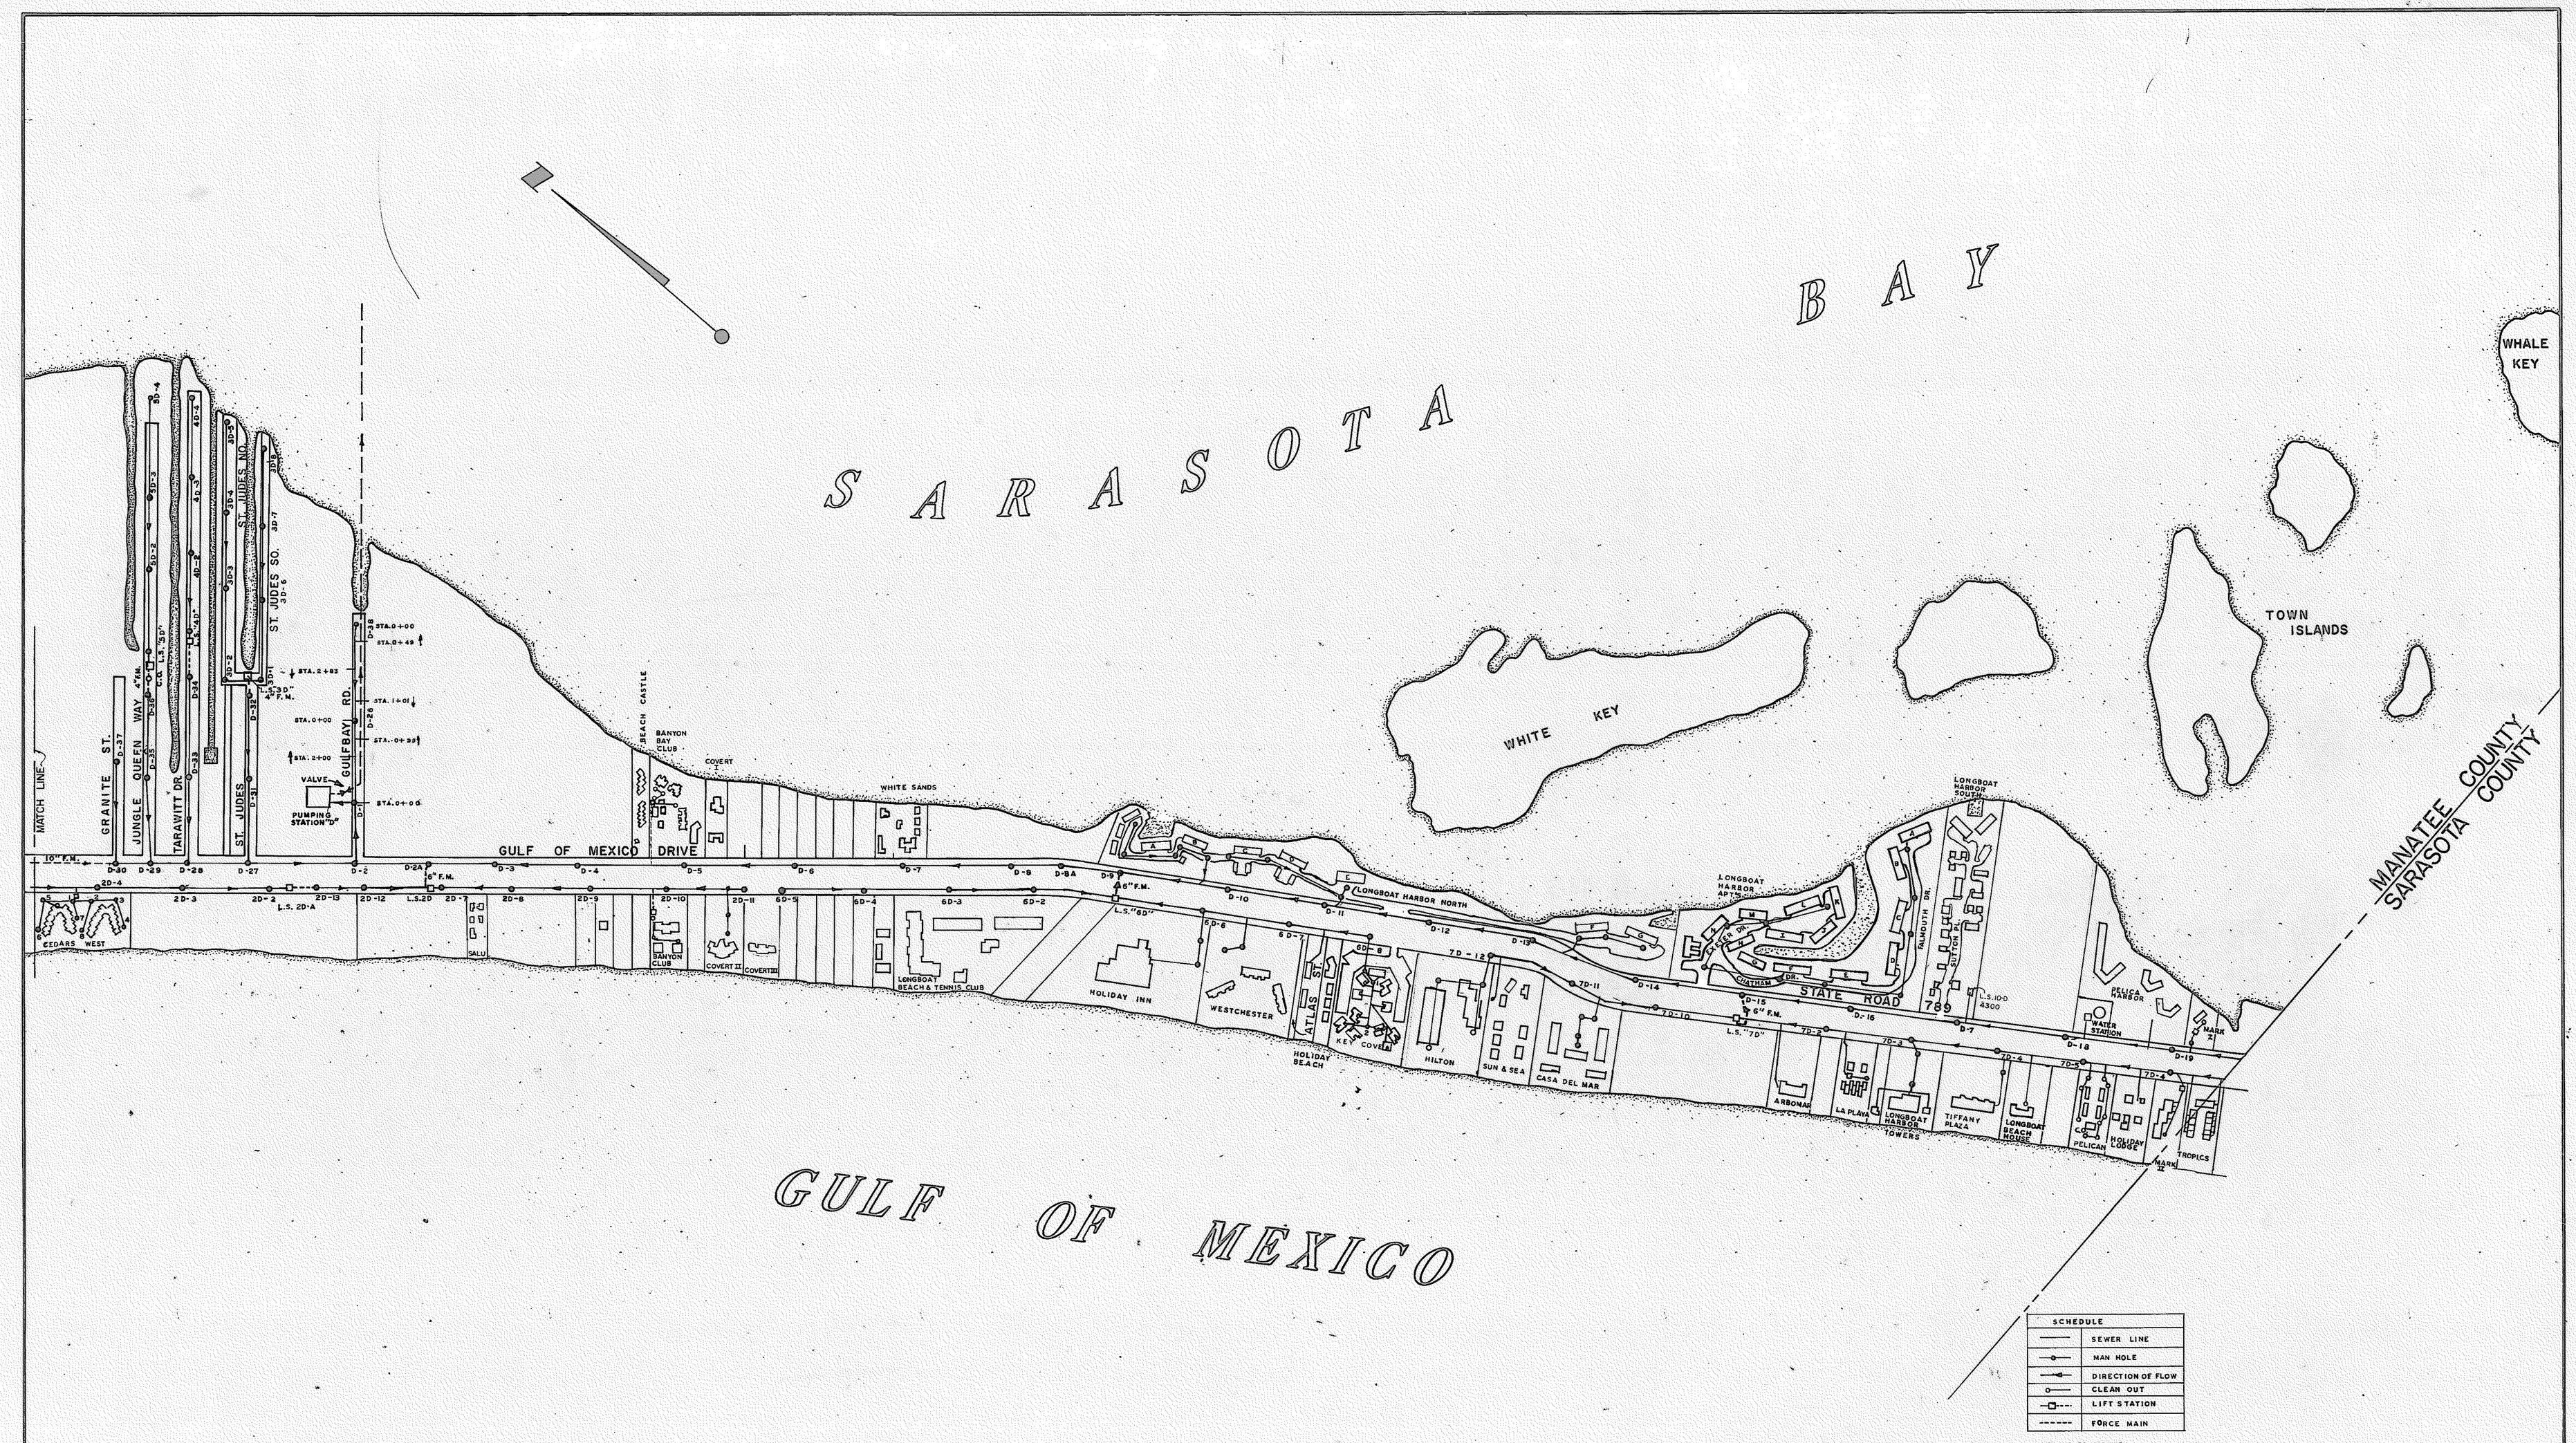

LTR	DATE	REVISION	BY	SCALE	DATE	DESIGNED BY	FOR	APPROVED BY	SHEET NUMBER
"A"	6-20-78	UP-DATE AS BUILTS THRU MAY, 78.	L.J.V.	1" = 400'			TOWN OF LONGBOAT KEY, FLORIDA		S-2
				DRAWN BY	CHECKED BY	PROJECT NO. 1217-S	MASTER PLAN WASTEWATER COLLECTION SYSTEM LONGBOAT KEY, FLORIDA	DONALD J. SMALLY, P.E. FLA. CERT. NO. 5051	REVISION "A"

SMALLY, WELLFORD & NALVEN — CONSULTING ENGINEERS — SARASOTA, FLORIDA

INDEX NO. E-1/2 17-5-3433

5