


PROFILE

GREELEY AND HANSEN ENGINEERS
 1211 N. WEST SHORE BLVD.
 TAMPA, FLORIDA 33607

DESIGNED RSH
 DRAWN AA

APPROVED
 DATE _____
 TOWN OF LONGBOAT KEY

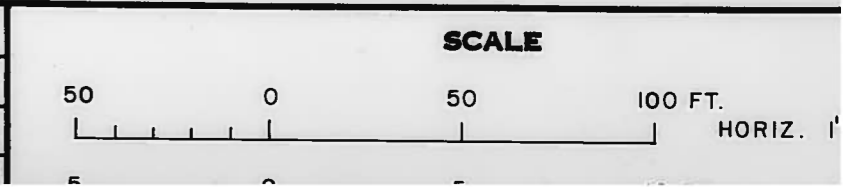

9/19/84 TIW Record Draw Revisions