


SEE SHEET 8

SEE SHEET 9

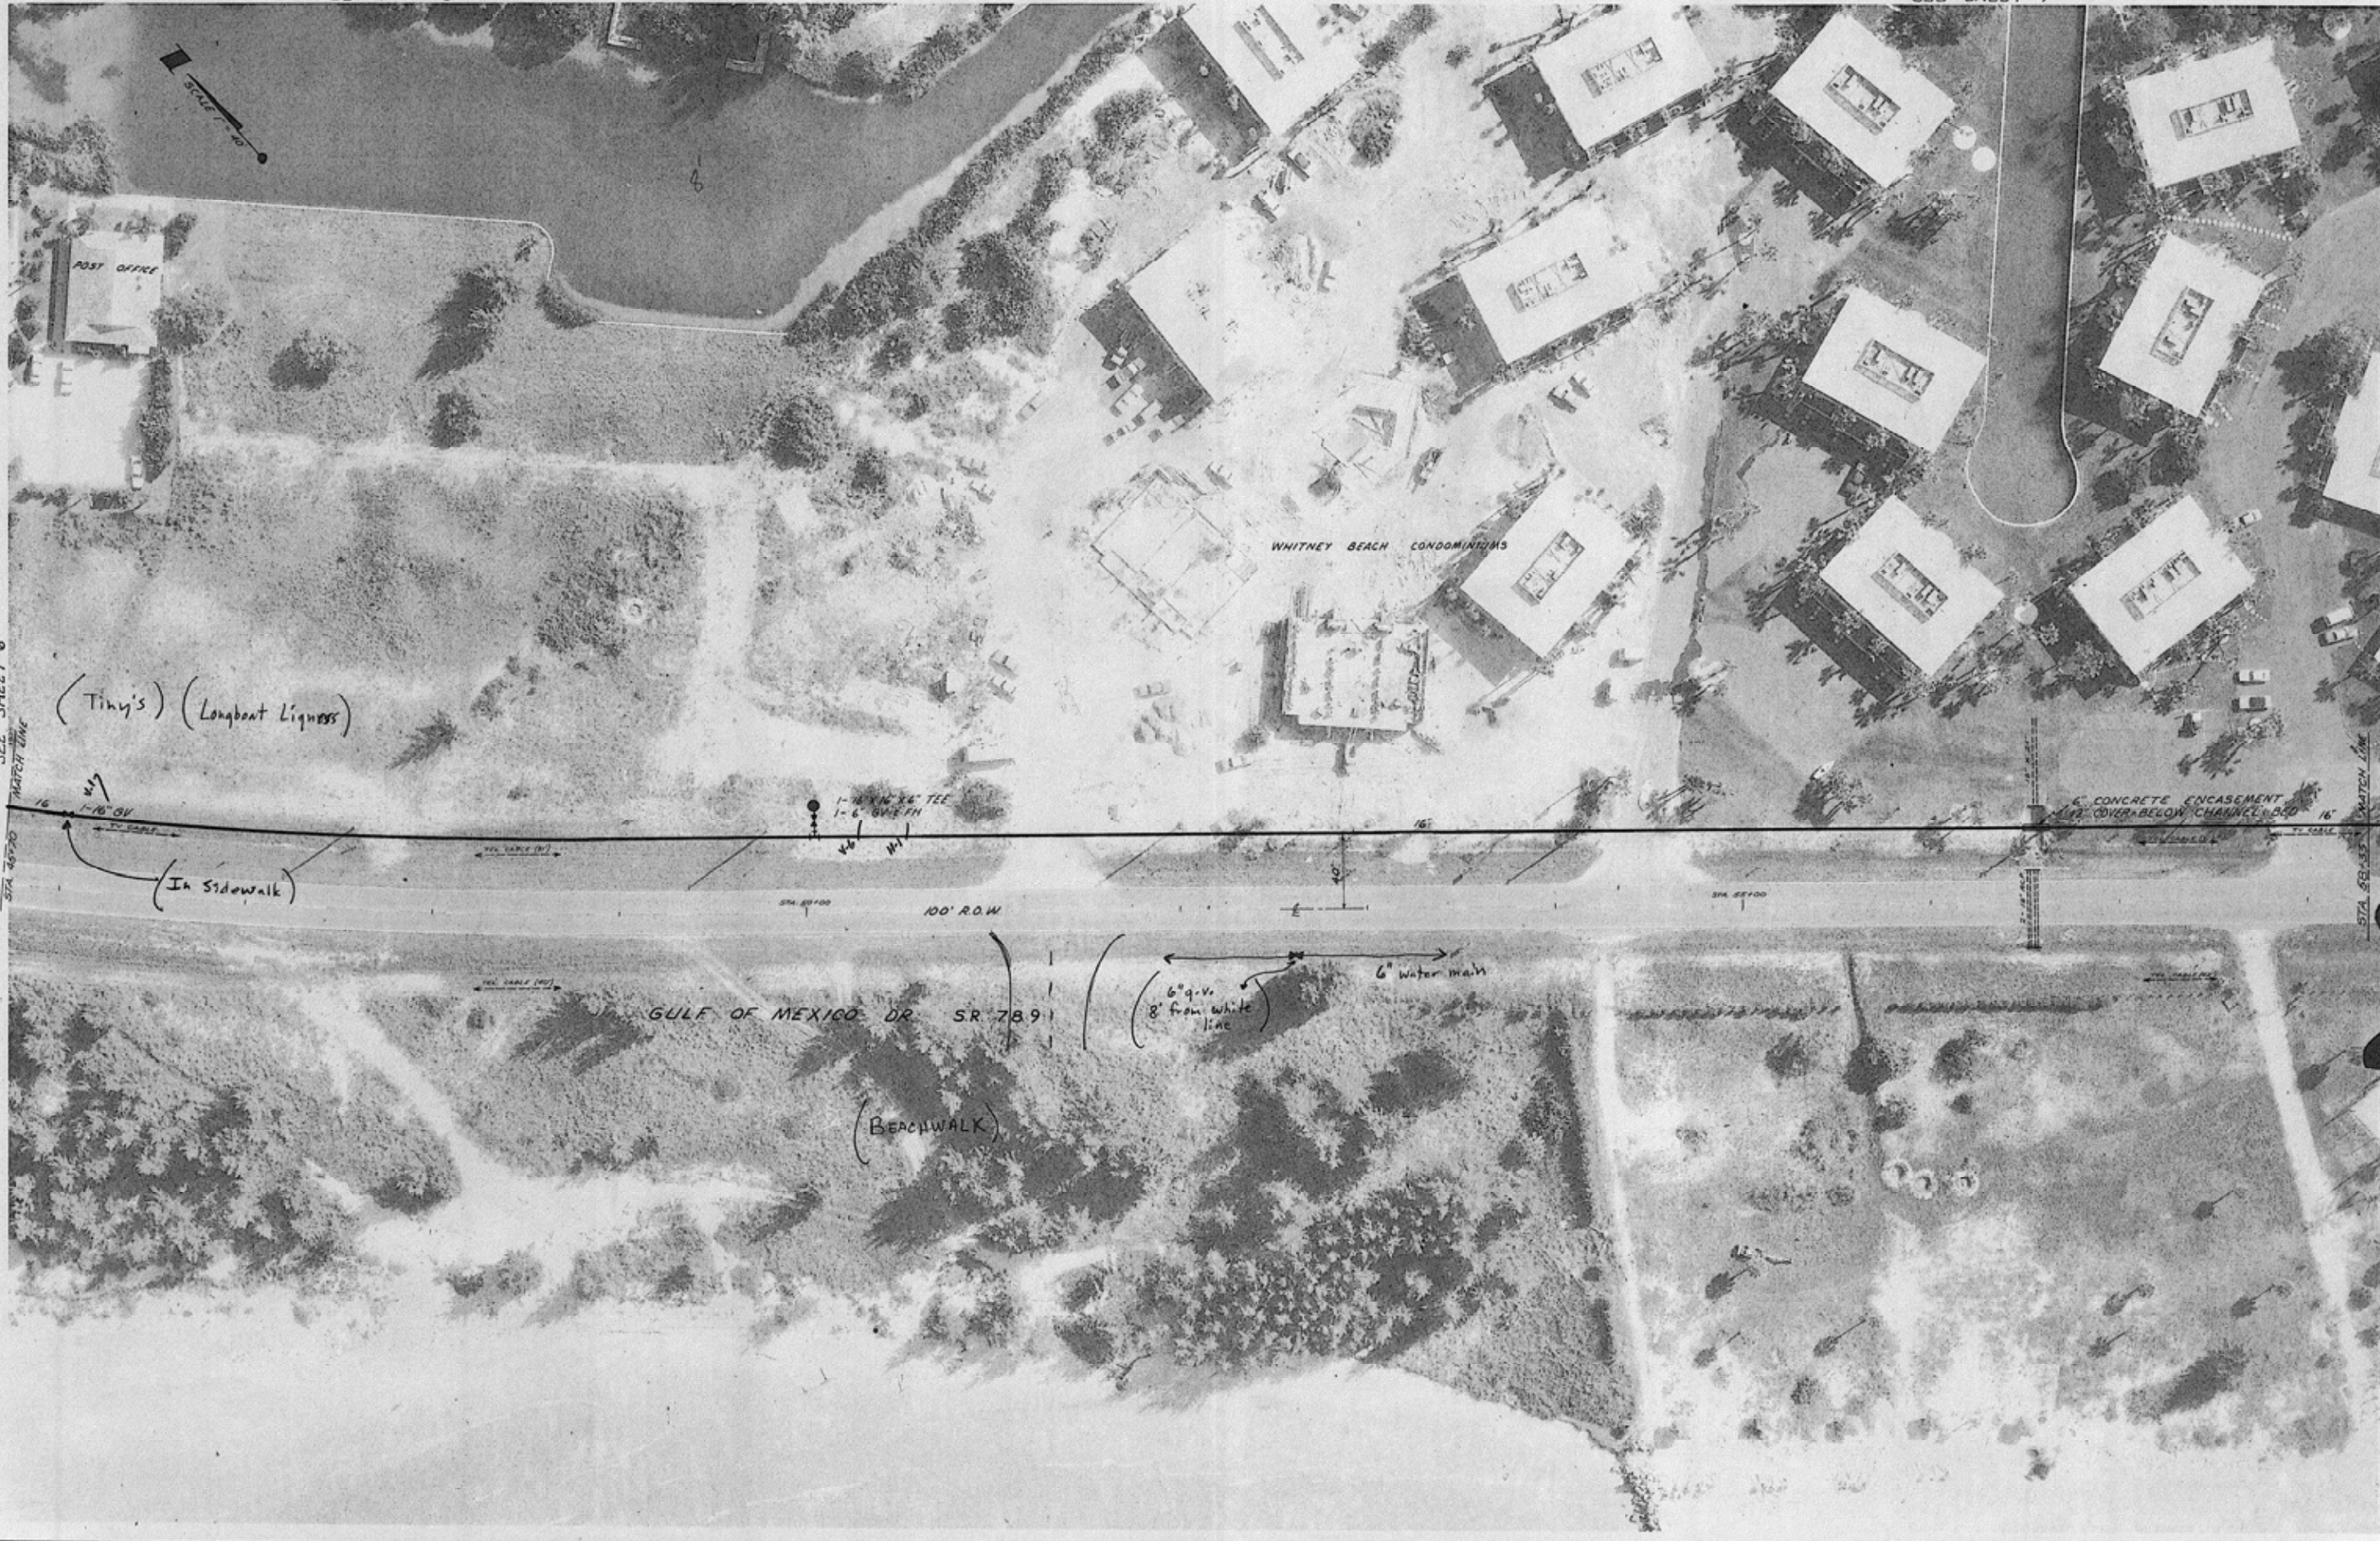

SEE SHEET 6
STA 85+70
MATCH LINE

SEE SHEET 12
STA 80+50
MATCH LINE

FOR: TOWN OF LONGBOAT KEY, FLORIDA	DATE	REVISION	BY	SCALE	DATES	DESIGNED BY	APPROVED BY
WATER DISTRIBUTION SYSTEM LONGBOAT KEY, FLORIDA	12-14-70	ADDED 16" G.V.	L.D.L.	1" = 40'	12-18-70	E.W.N.	Marion Wellford
	1-4-71	ADDED ENCASUREMENT COVER	E.W.N.	7/16			
SHEET NUMBER	L.T.R.						
11	29"						
REVISION							
3"							
SMALLY · WELLFORD & NALVEN — CONSULTING ENGINEERS — SARASOTA, FLA.							
INDEX NO. E-1217-29							