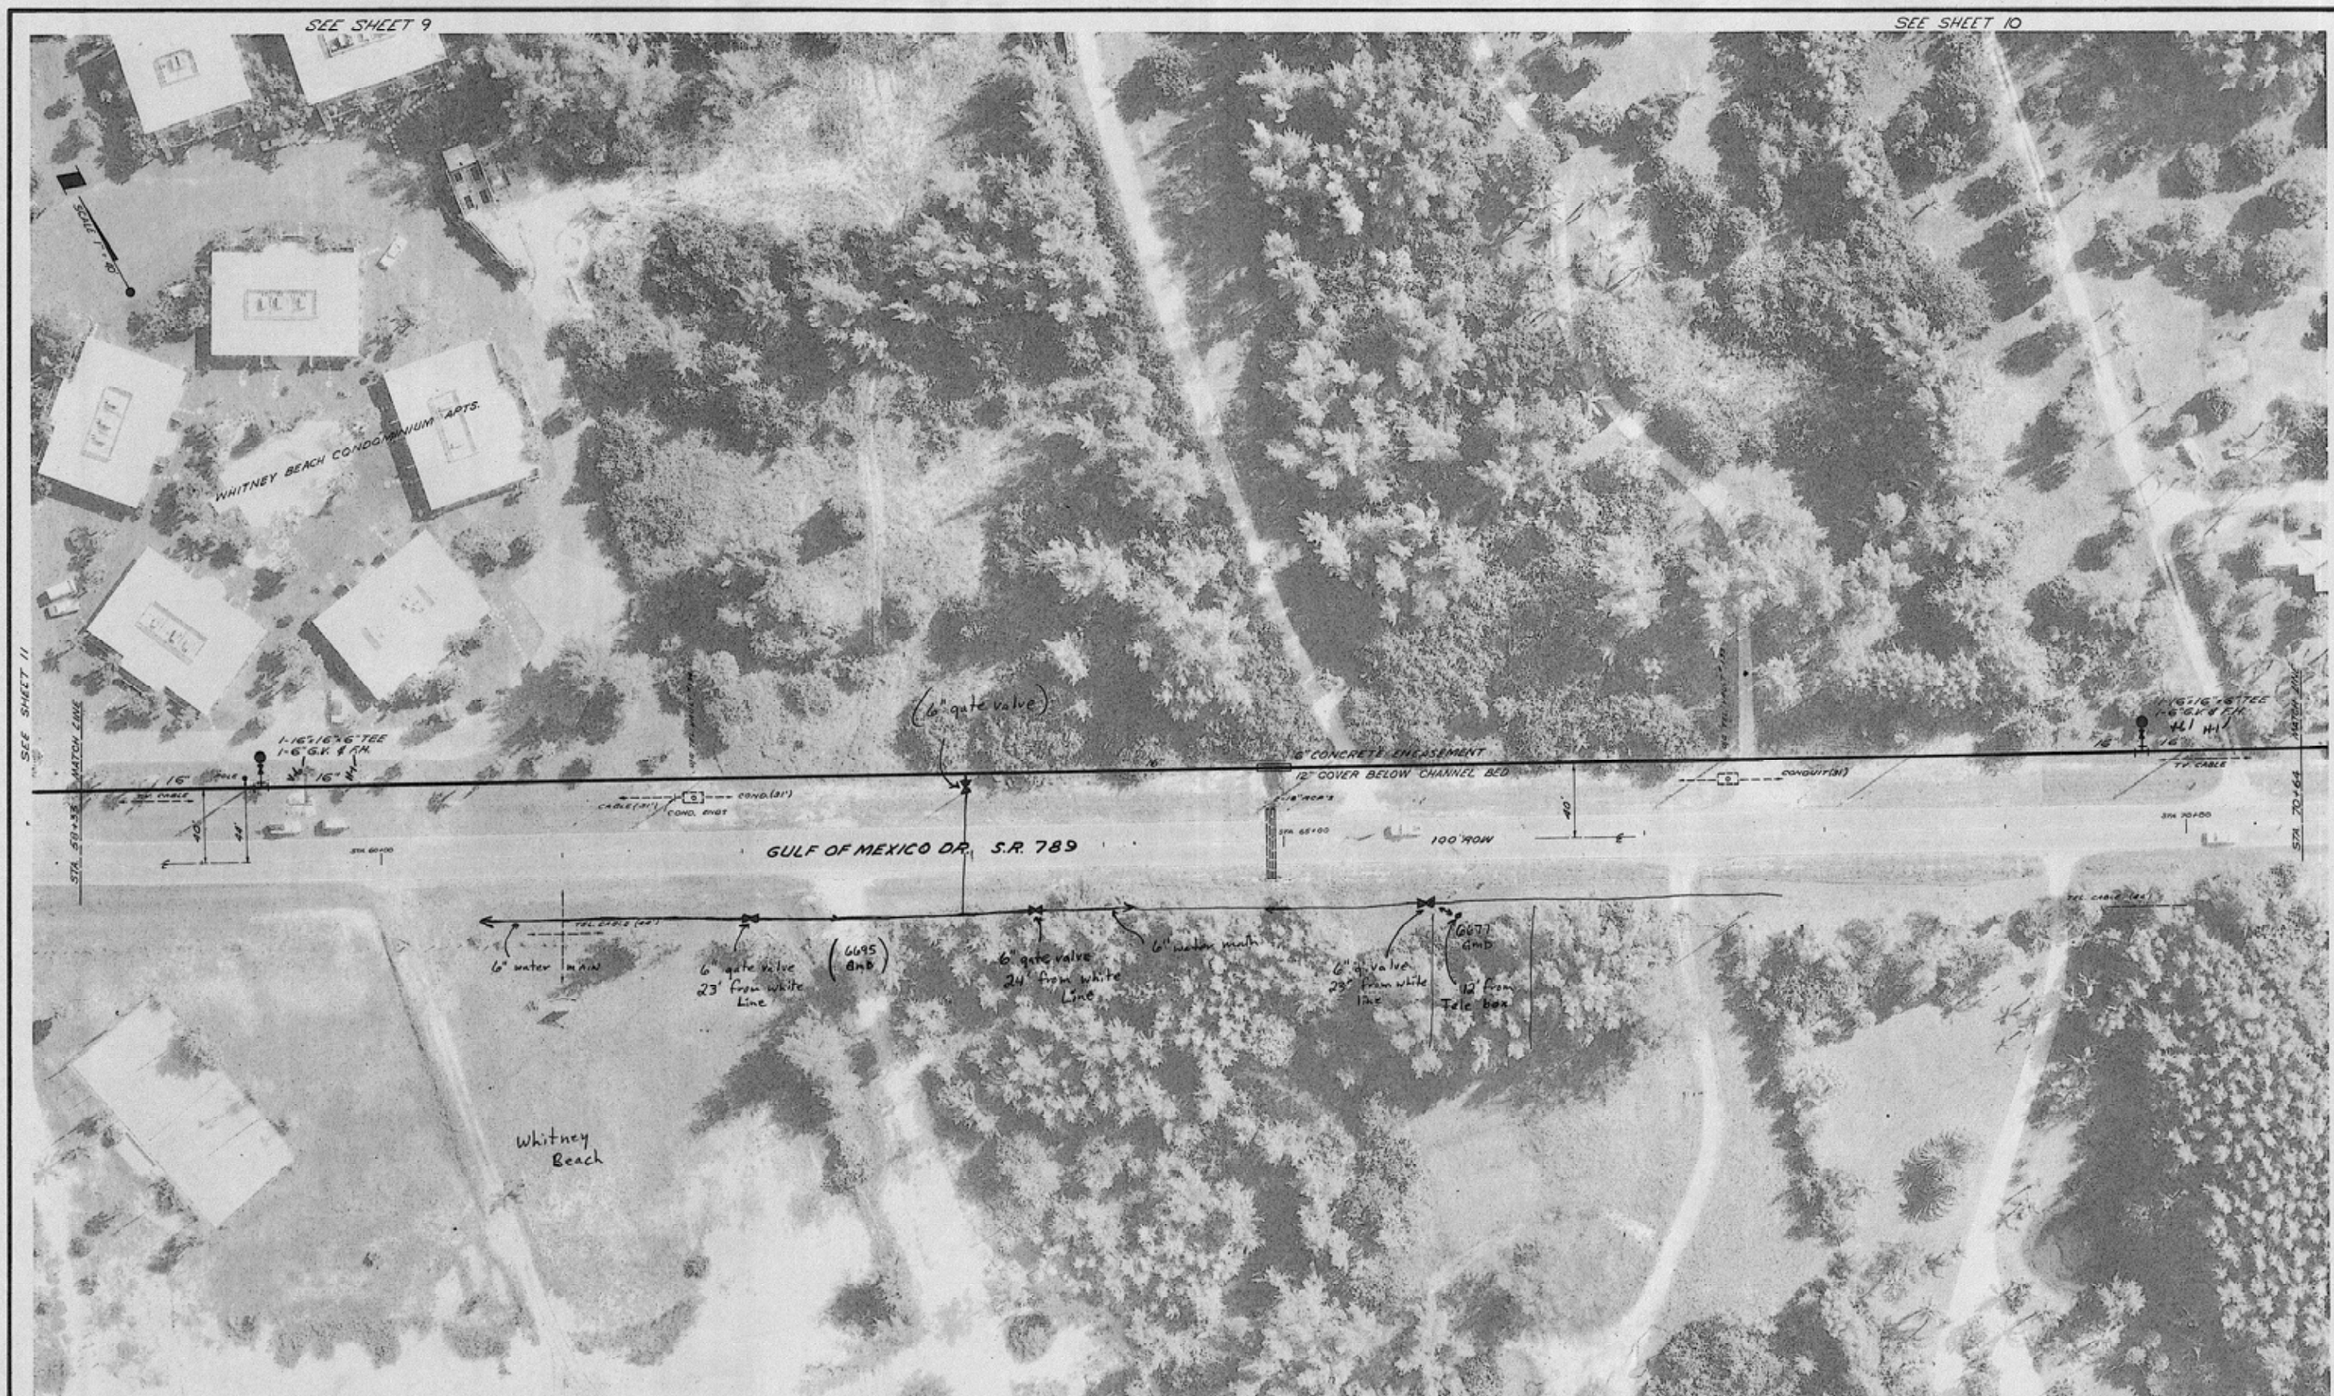


| LTR. | DATE | REVISION | BY |
|---|---|---|---|
| "A" | 2-4-71 | ADDED ENCASEMENT COVERING | E.W.N. |

SCALE 1" = 40'
DATES Plans sept 8, 1970 12-10-70
DRAWN BY
CHECKED BY
DESIGNED BY E.W.N.
APPROVED BY Marion Wellford
MARION WELLFORD, P.E. FLA. CERT. NO. 5367
PROJECT NO. 1217

FOR: TOWN OF LONGBOAT KEY, FLORIDA

# WATER DISTRIBUTION SYSTEM

LONGBOAT KEY, FLORIDA

SMALLY · WELLFORD & NALVEN — CONSULTING ENGINEERS — SARASOTA, FLA.

SHEET NUMBER 12

REVISION "A"

INDEX NO. E-1217-30