


SEE SHEET 13

SEE SHEET 15

SEE SHEET 18

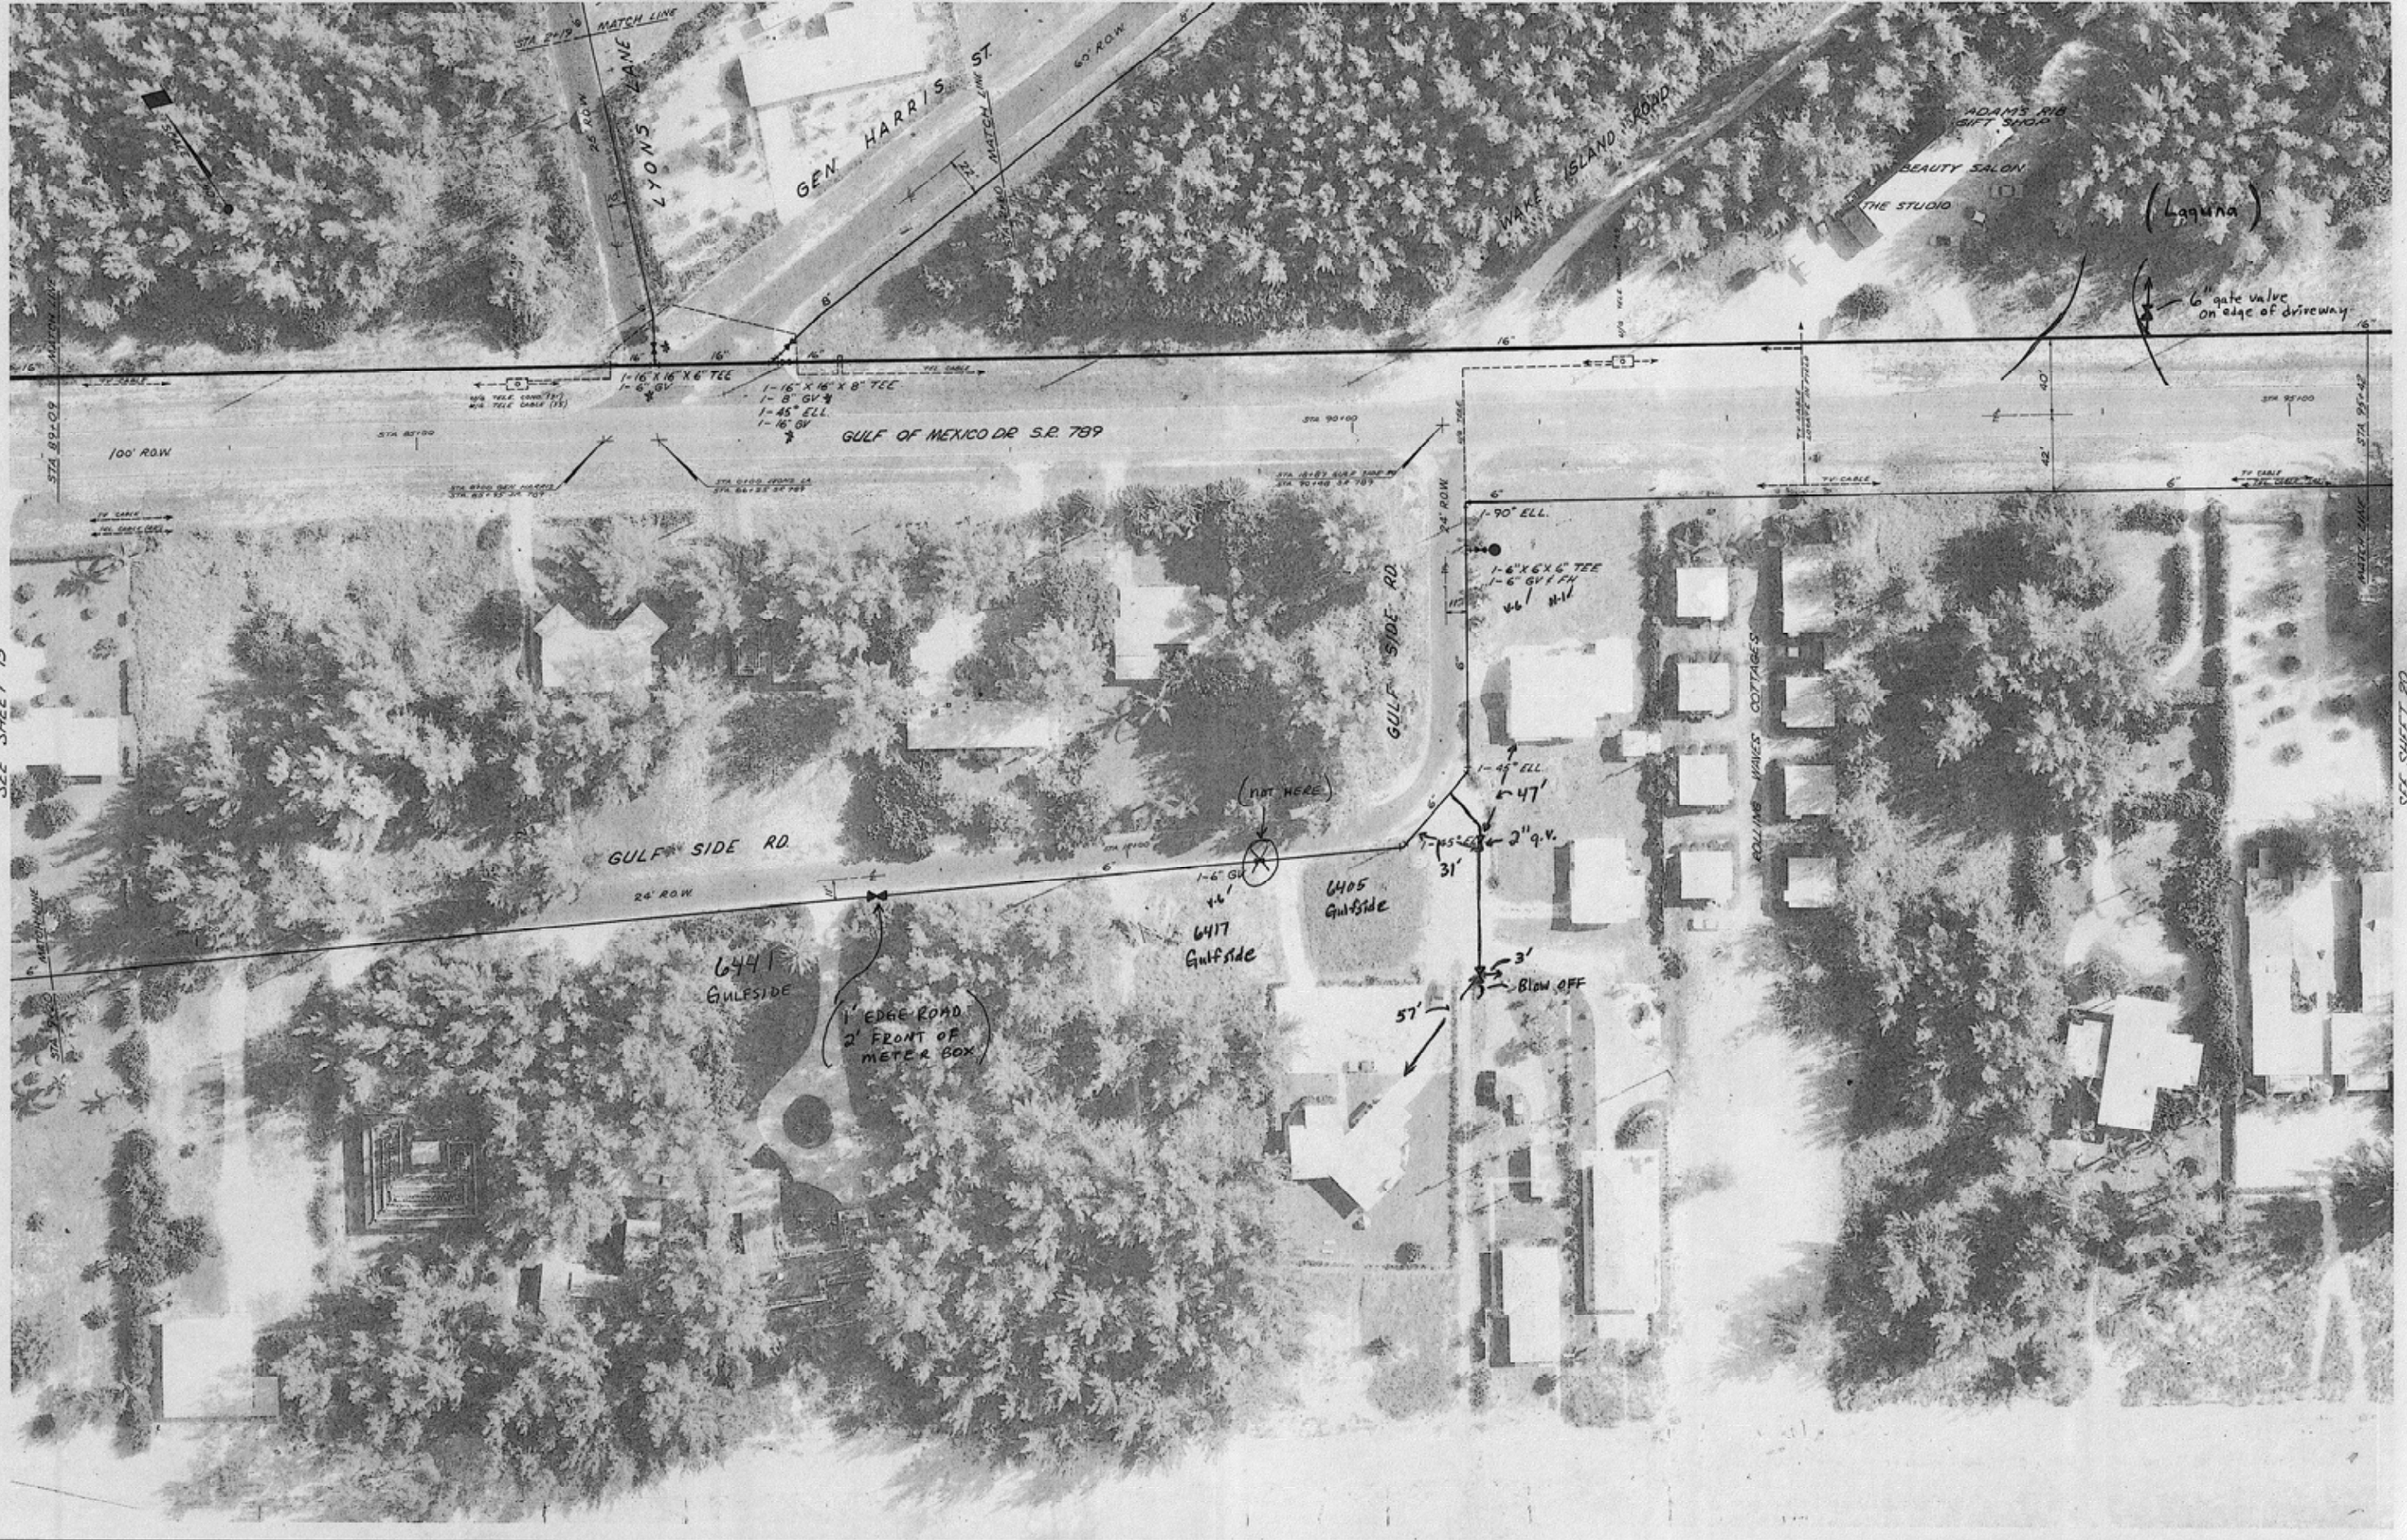

FOR: TOWN OF LONGBOAT KEY, FLORIDA	REVISION	DATE	L.T.R.
WATER DISTRIBUTION SYSTEM	ADDED 12" V.C.	12-1-70	34"
LONGBOAT KEY, FLORIDA			
SMALLY · WELLFORD & NALVEN — CONSULTING ENGINEERS — SARASOTA, FLA.			
INDEX NO. F-1217-35			
SHEET NUMBER	17	PROJECT NO.	1217
REVISION	34"	DESIGNED BY	E.W.N.
		CHECKED BY	T.L.E.
		DRAWN BY	T.L.E.
		SCALE	1" = 40'
		DATES	FLORIDA PER. NO. 12-10-70
		APPROVED BY	Marion Wellford
			MARION WELLFORD, P.E. FLA. CERT. NO. 5367