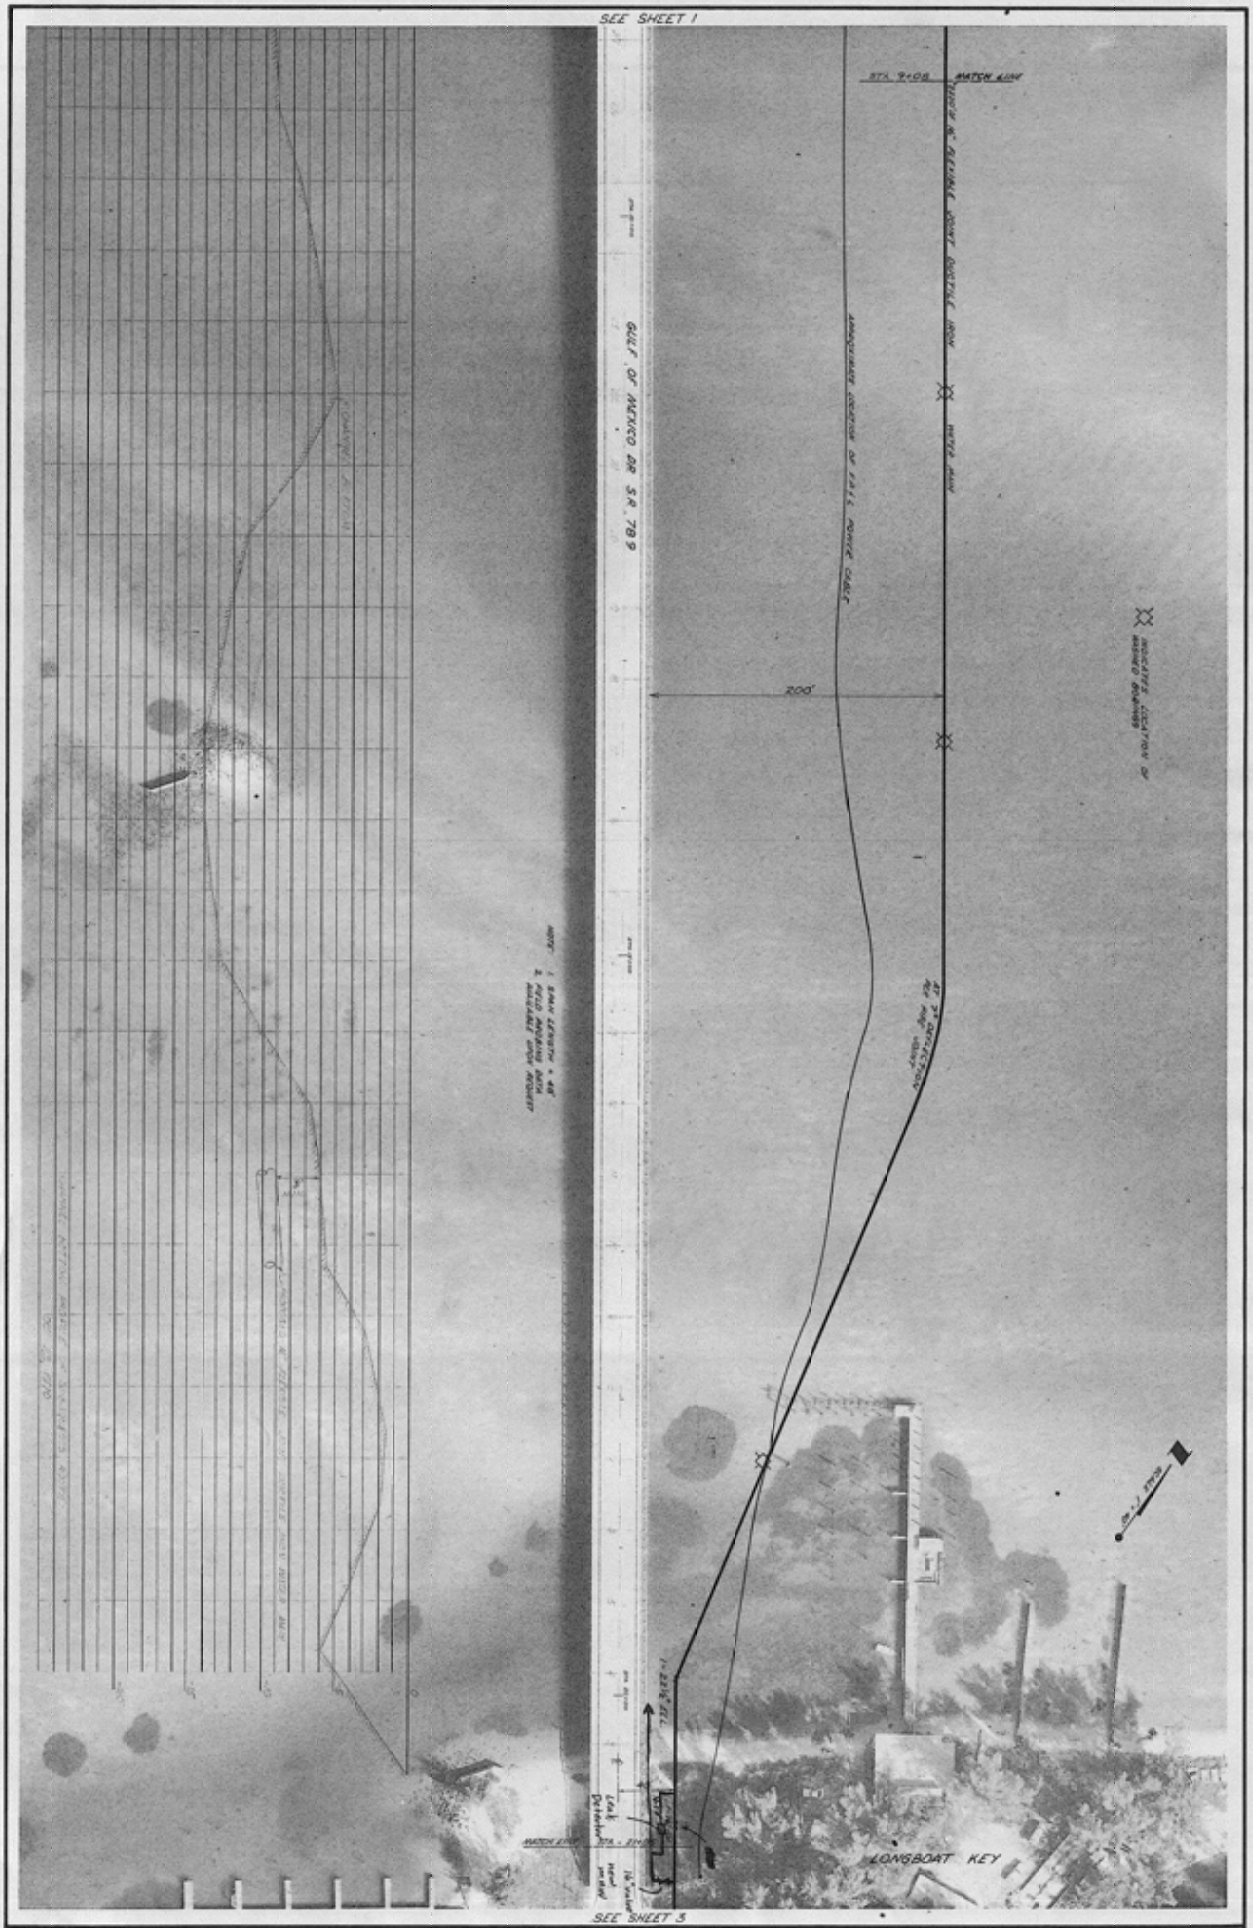

REVISION NO. 2	FOR: TOWN OF LONGBOAT KEY, FLORIDA	LTR.	DATE	REVISION	BY	SCALE	DATES	DESIGNED BY: E.W.N.	APPROVED BY:
	WATER DISTRIBUTION SYSTEM	56"	12-18-70	ADDED F.P.L. CROSSING AND INDICATED PIKEN BOREHOLES	E.D.L.	1" = 40'		DRAWN BY: TLL	CHECKED BY:	PROJECT NO. 1217	MARION WELLFORD, P.E. FLA. CERT. NO. 5367

SMALLY · WELLFORD & NALVEN — CONSULTING ENGINEERS — SARASOTA, FLA.

INDEX NO. E-1217-20