


SEE SHEET 17

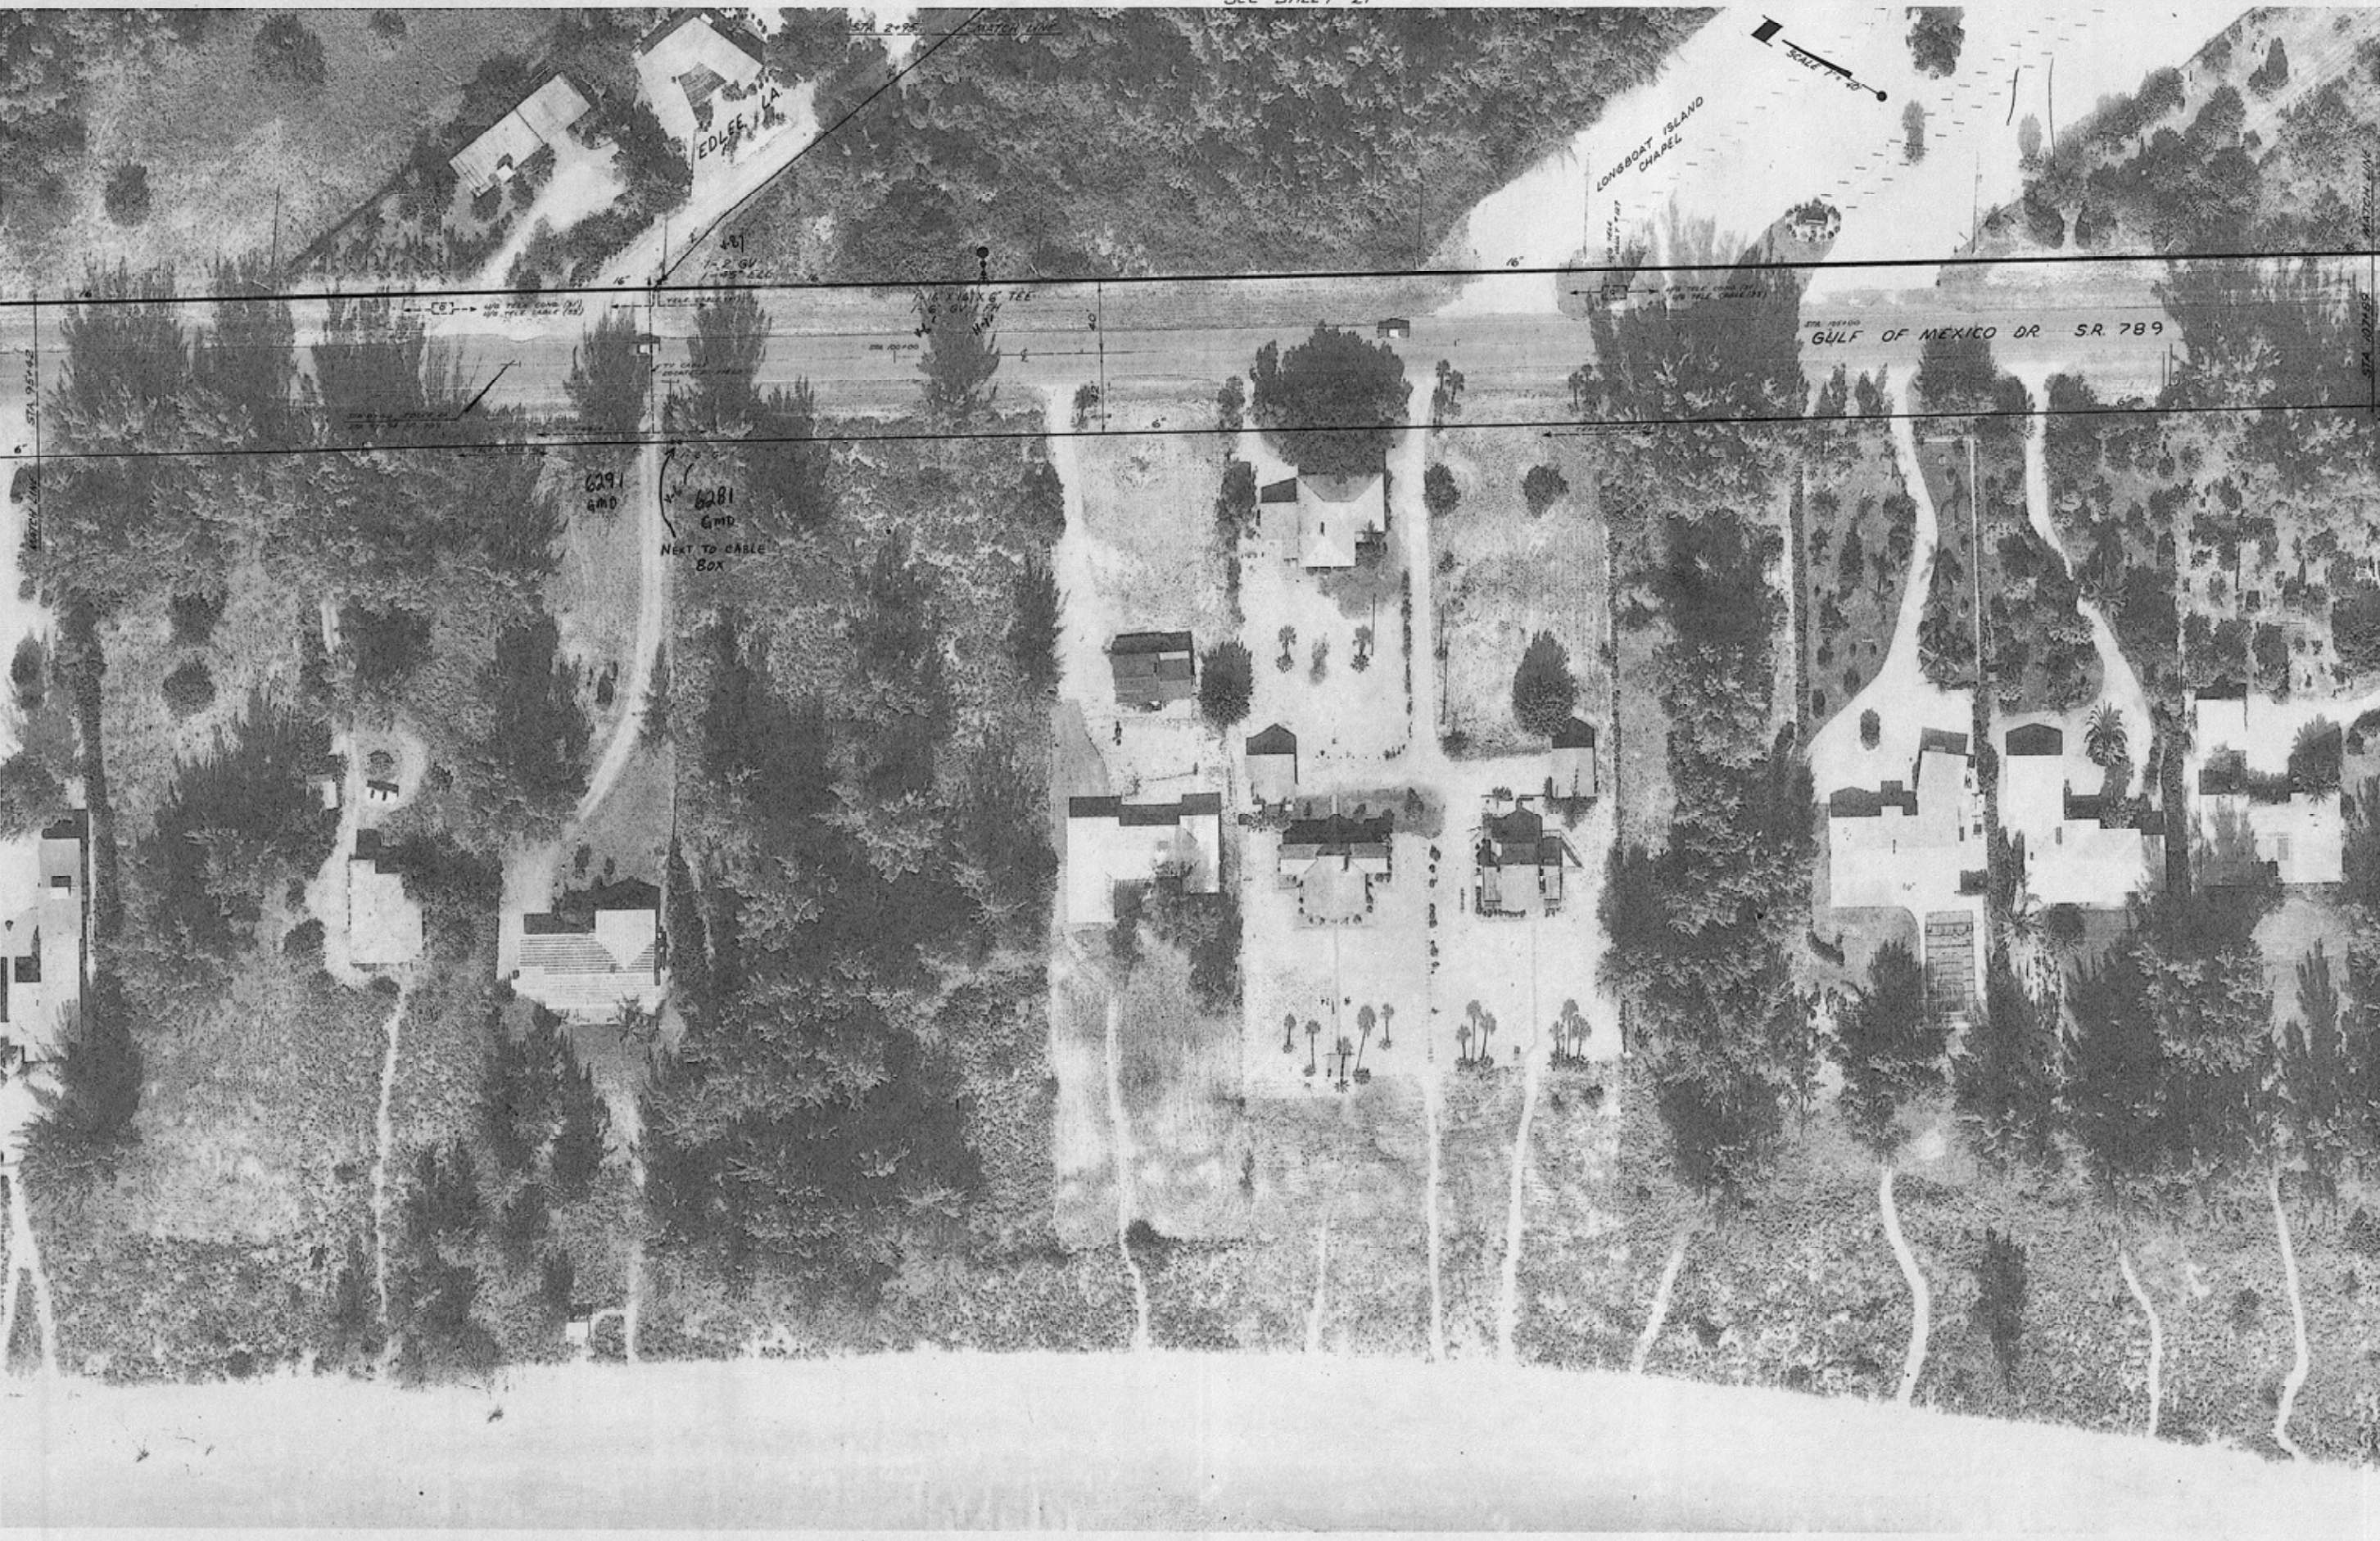

SEE SHEET 21

SEE SHEET 22

FOR: TOWN OF LONGBOAT KEY, FLORIDA	LTR. DATE	REVISION	BY	SCALE	DATES	DESIGNED BY	APPROVED BY
<b>WATER DISTRIBUTION SYSTEM</b> LONGBOAT KEY, FLORIDA				1" = 40'	FORM 807-A, 1970 12-10-70	E.W.N.	M. Wellford
						CHECKED BY	PROJECT NO
						722	1217
							MARION WELLFORD, PE FLA. CERT. NO. 5367
SMALLY · WELLFORD & NALVEN — CONSULTING ENGINEERS — SARASOTA, FLA.							
INDEX NO E-1217-38							
SHEET NUMBER				20			
REVISION							