


SEE SHEET 25

SEE SHEET 26

SHEET 24

SEE SHEET 20

SEE SHEET 23

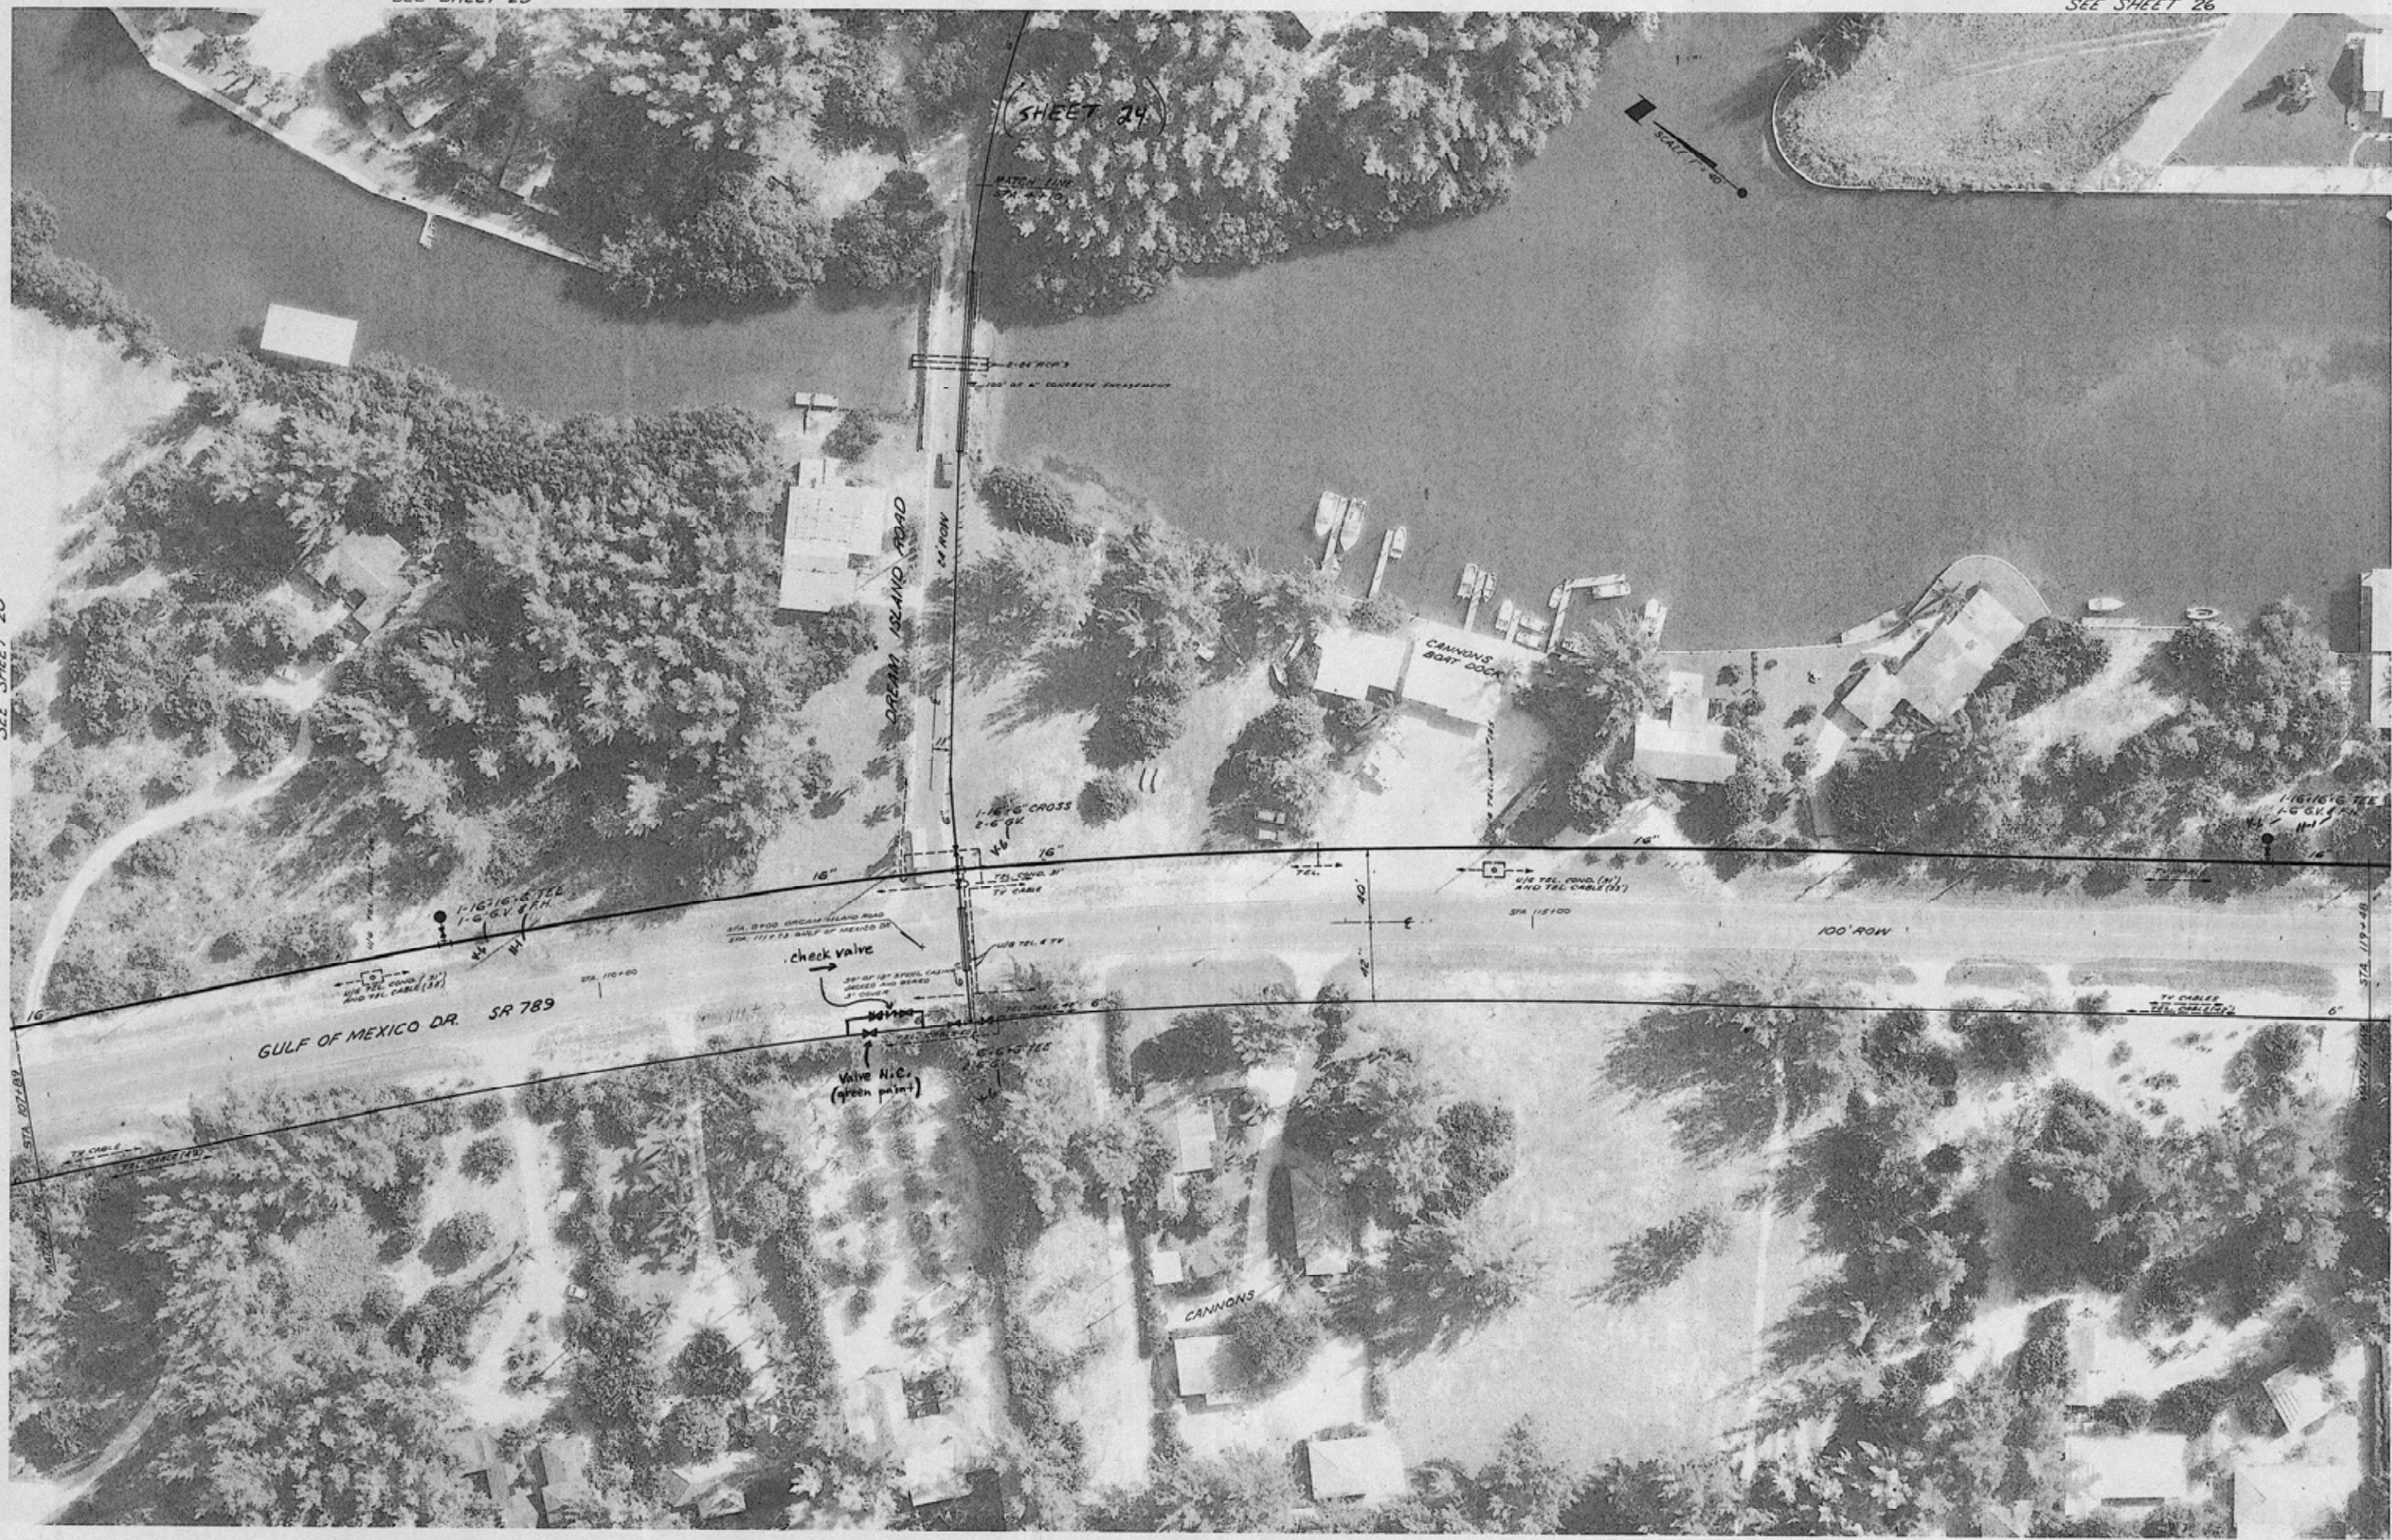

FOR: TOWN OF LONGBOAT KEY, FLORIDA	L.T.R. DATE	REVISION	BY	SCALE	DATES	DESIGNED BY	APPROVED BY	
WATER DISTRIBUTION SYSTEM LONGBOAT KEY, FLORIDA	24"	REMOVED 16" G.L.	L.D.L.	1" = 40'	12-10-70	E.W.N.	M. J. Wellford	
SHEETS	PROJECT NO.		CHECKED BY		DRAWN BY		INDEX NO.	
	1217		L.D.L.		L.D.L.		1217	
SMALLY - WELLFORD & NALVEN - CONSULTING ENGINEERS - SARASOTA, FLA.		MARION WELLFORD, P.E.		FLA. CERT. NO. 8387				
INDEX NO. E-1217-40	SHEET NUMBER		REVISION					
	22		24"					