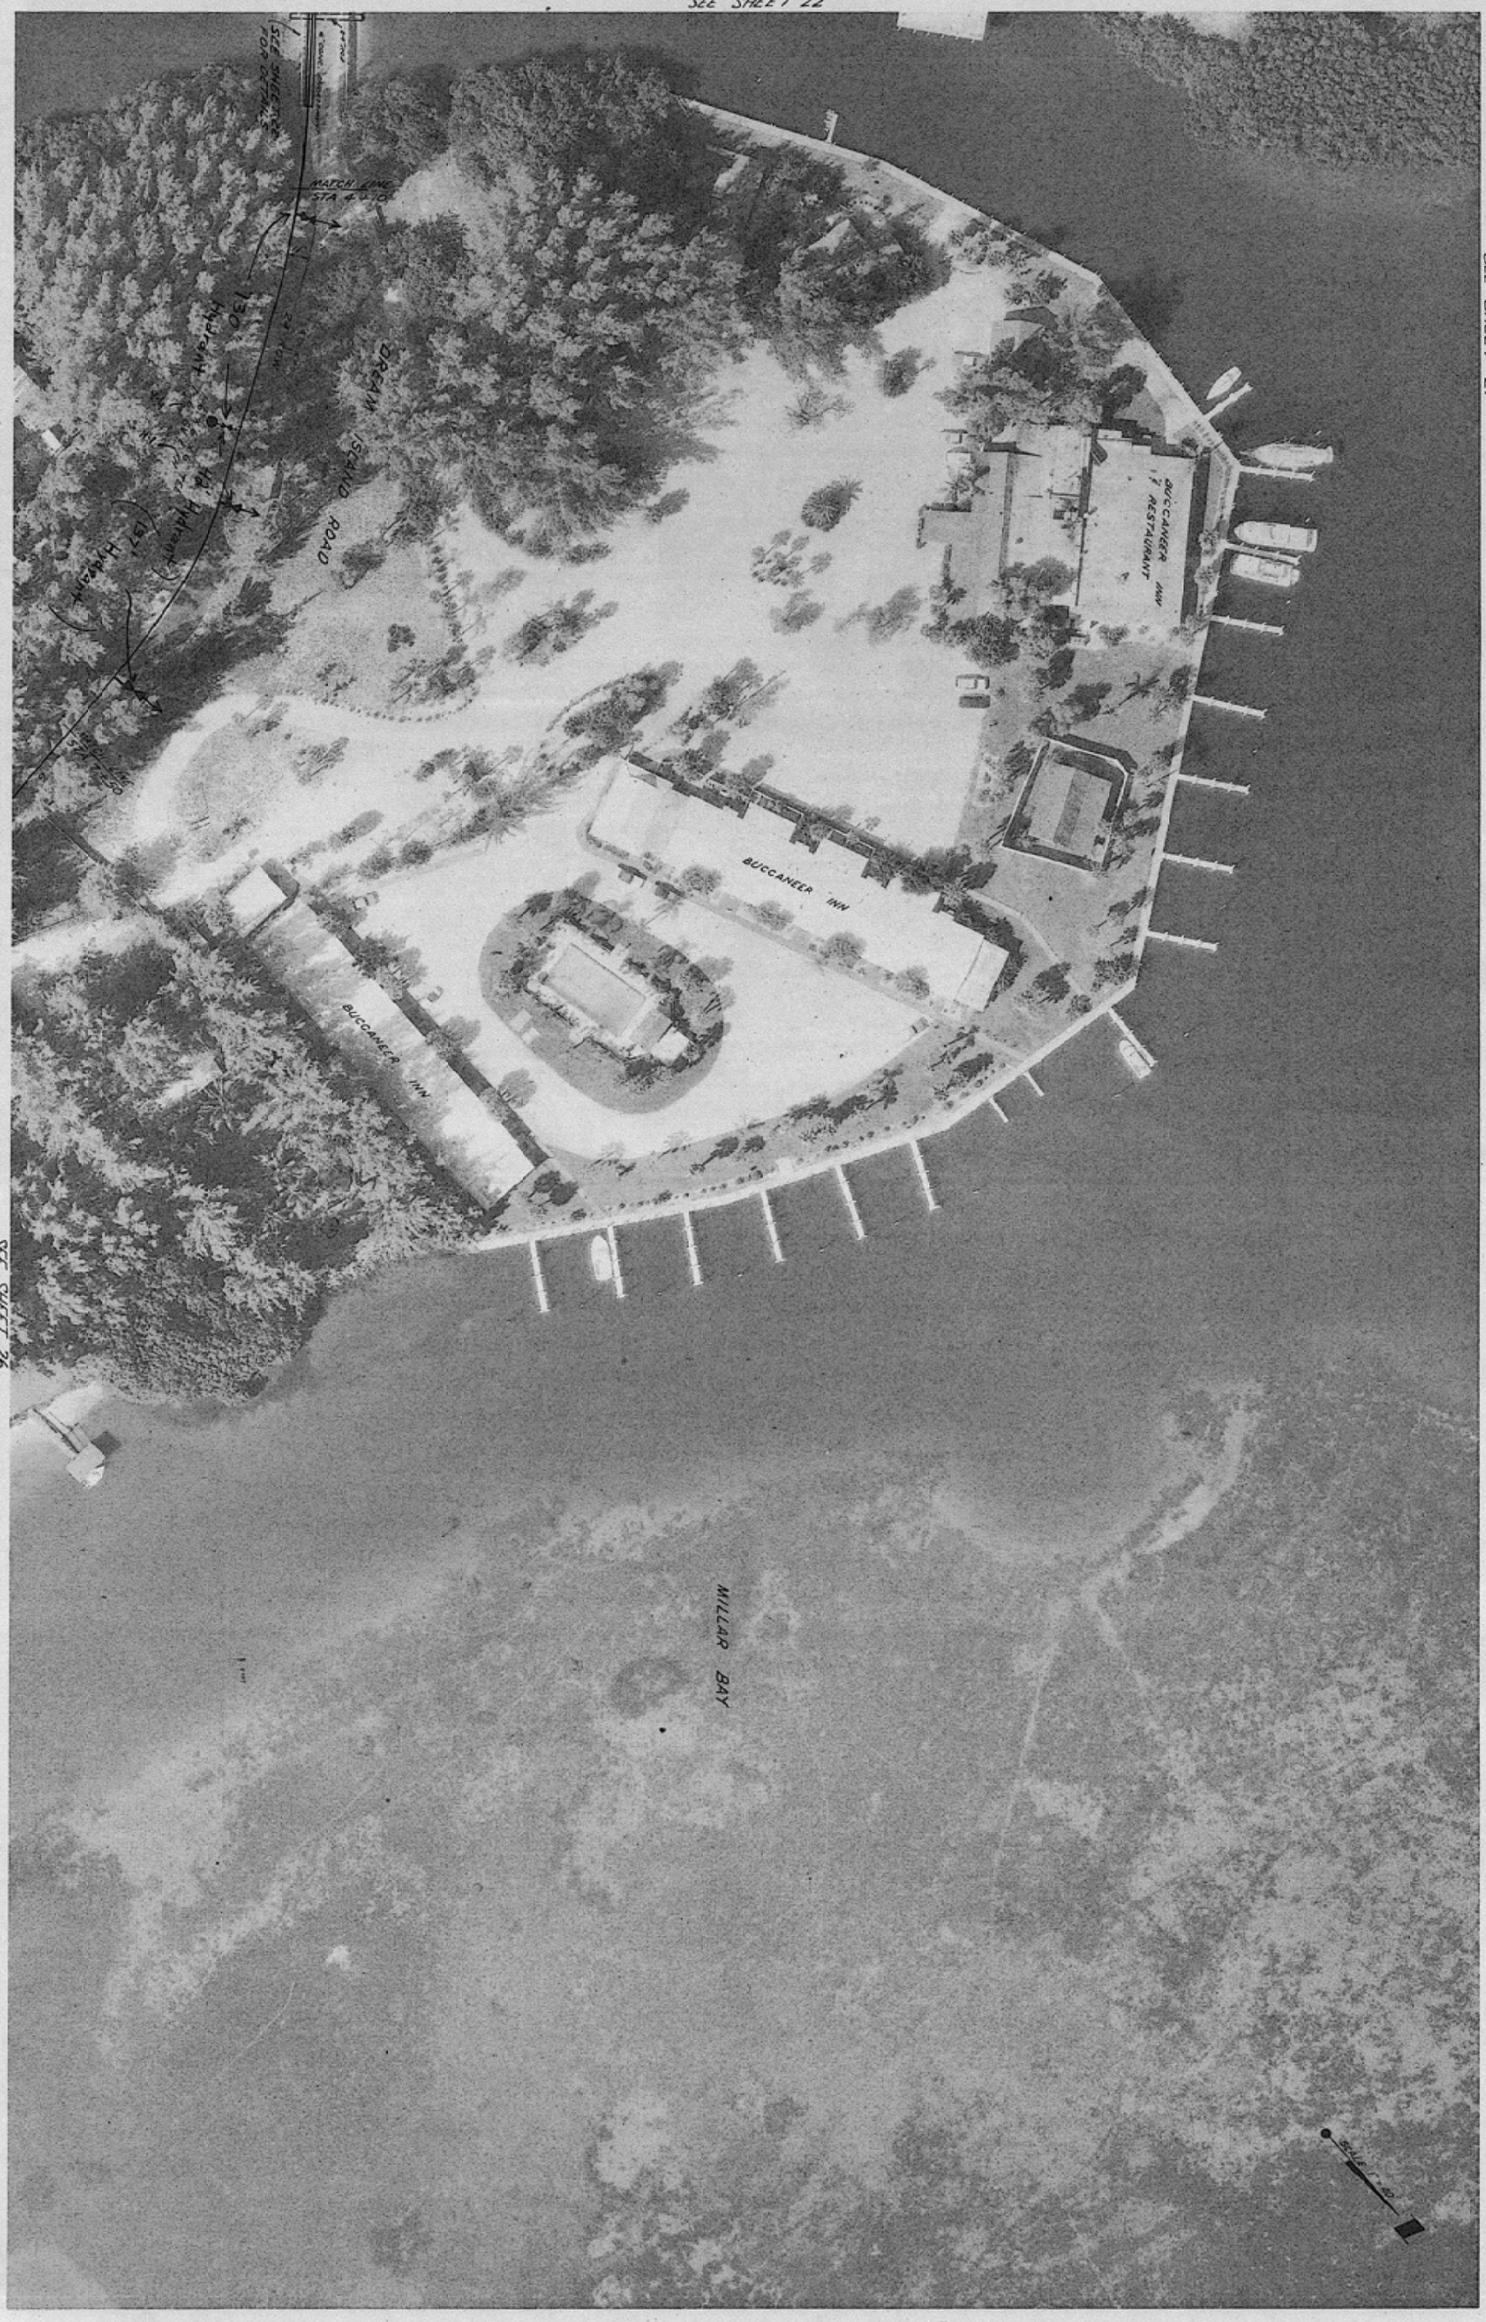

REVISION	SHEET NUMBER	FOR: TOWN OF LONGBOAT KEY, FLORIDA	LTR.	DATE	REVISION	BY	SCALE	DATES	DESIGNED BY	APPROVED BY:
	25	WATER DISTRIBUTION SYSTEM LONGBOAT KEY, FLORIDA					1" = 40'	FLDWK SEPT. 9, 1970 12-10-70	E.W.N.	Marion Wellford
							DRAWN BY TLE	CHECKED BY	PROJECT NO. 1217	MARION WELLFORD, P.E. FLA. CERT. NO. 5367

SMALLY · WELLFORD & NALVEN — CONSULTING ENGINEERS — SARASOTA, FLA.

INDEX NO. E-1217-43