


SEE SHEET 31

SEE SHEET 33

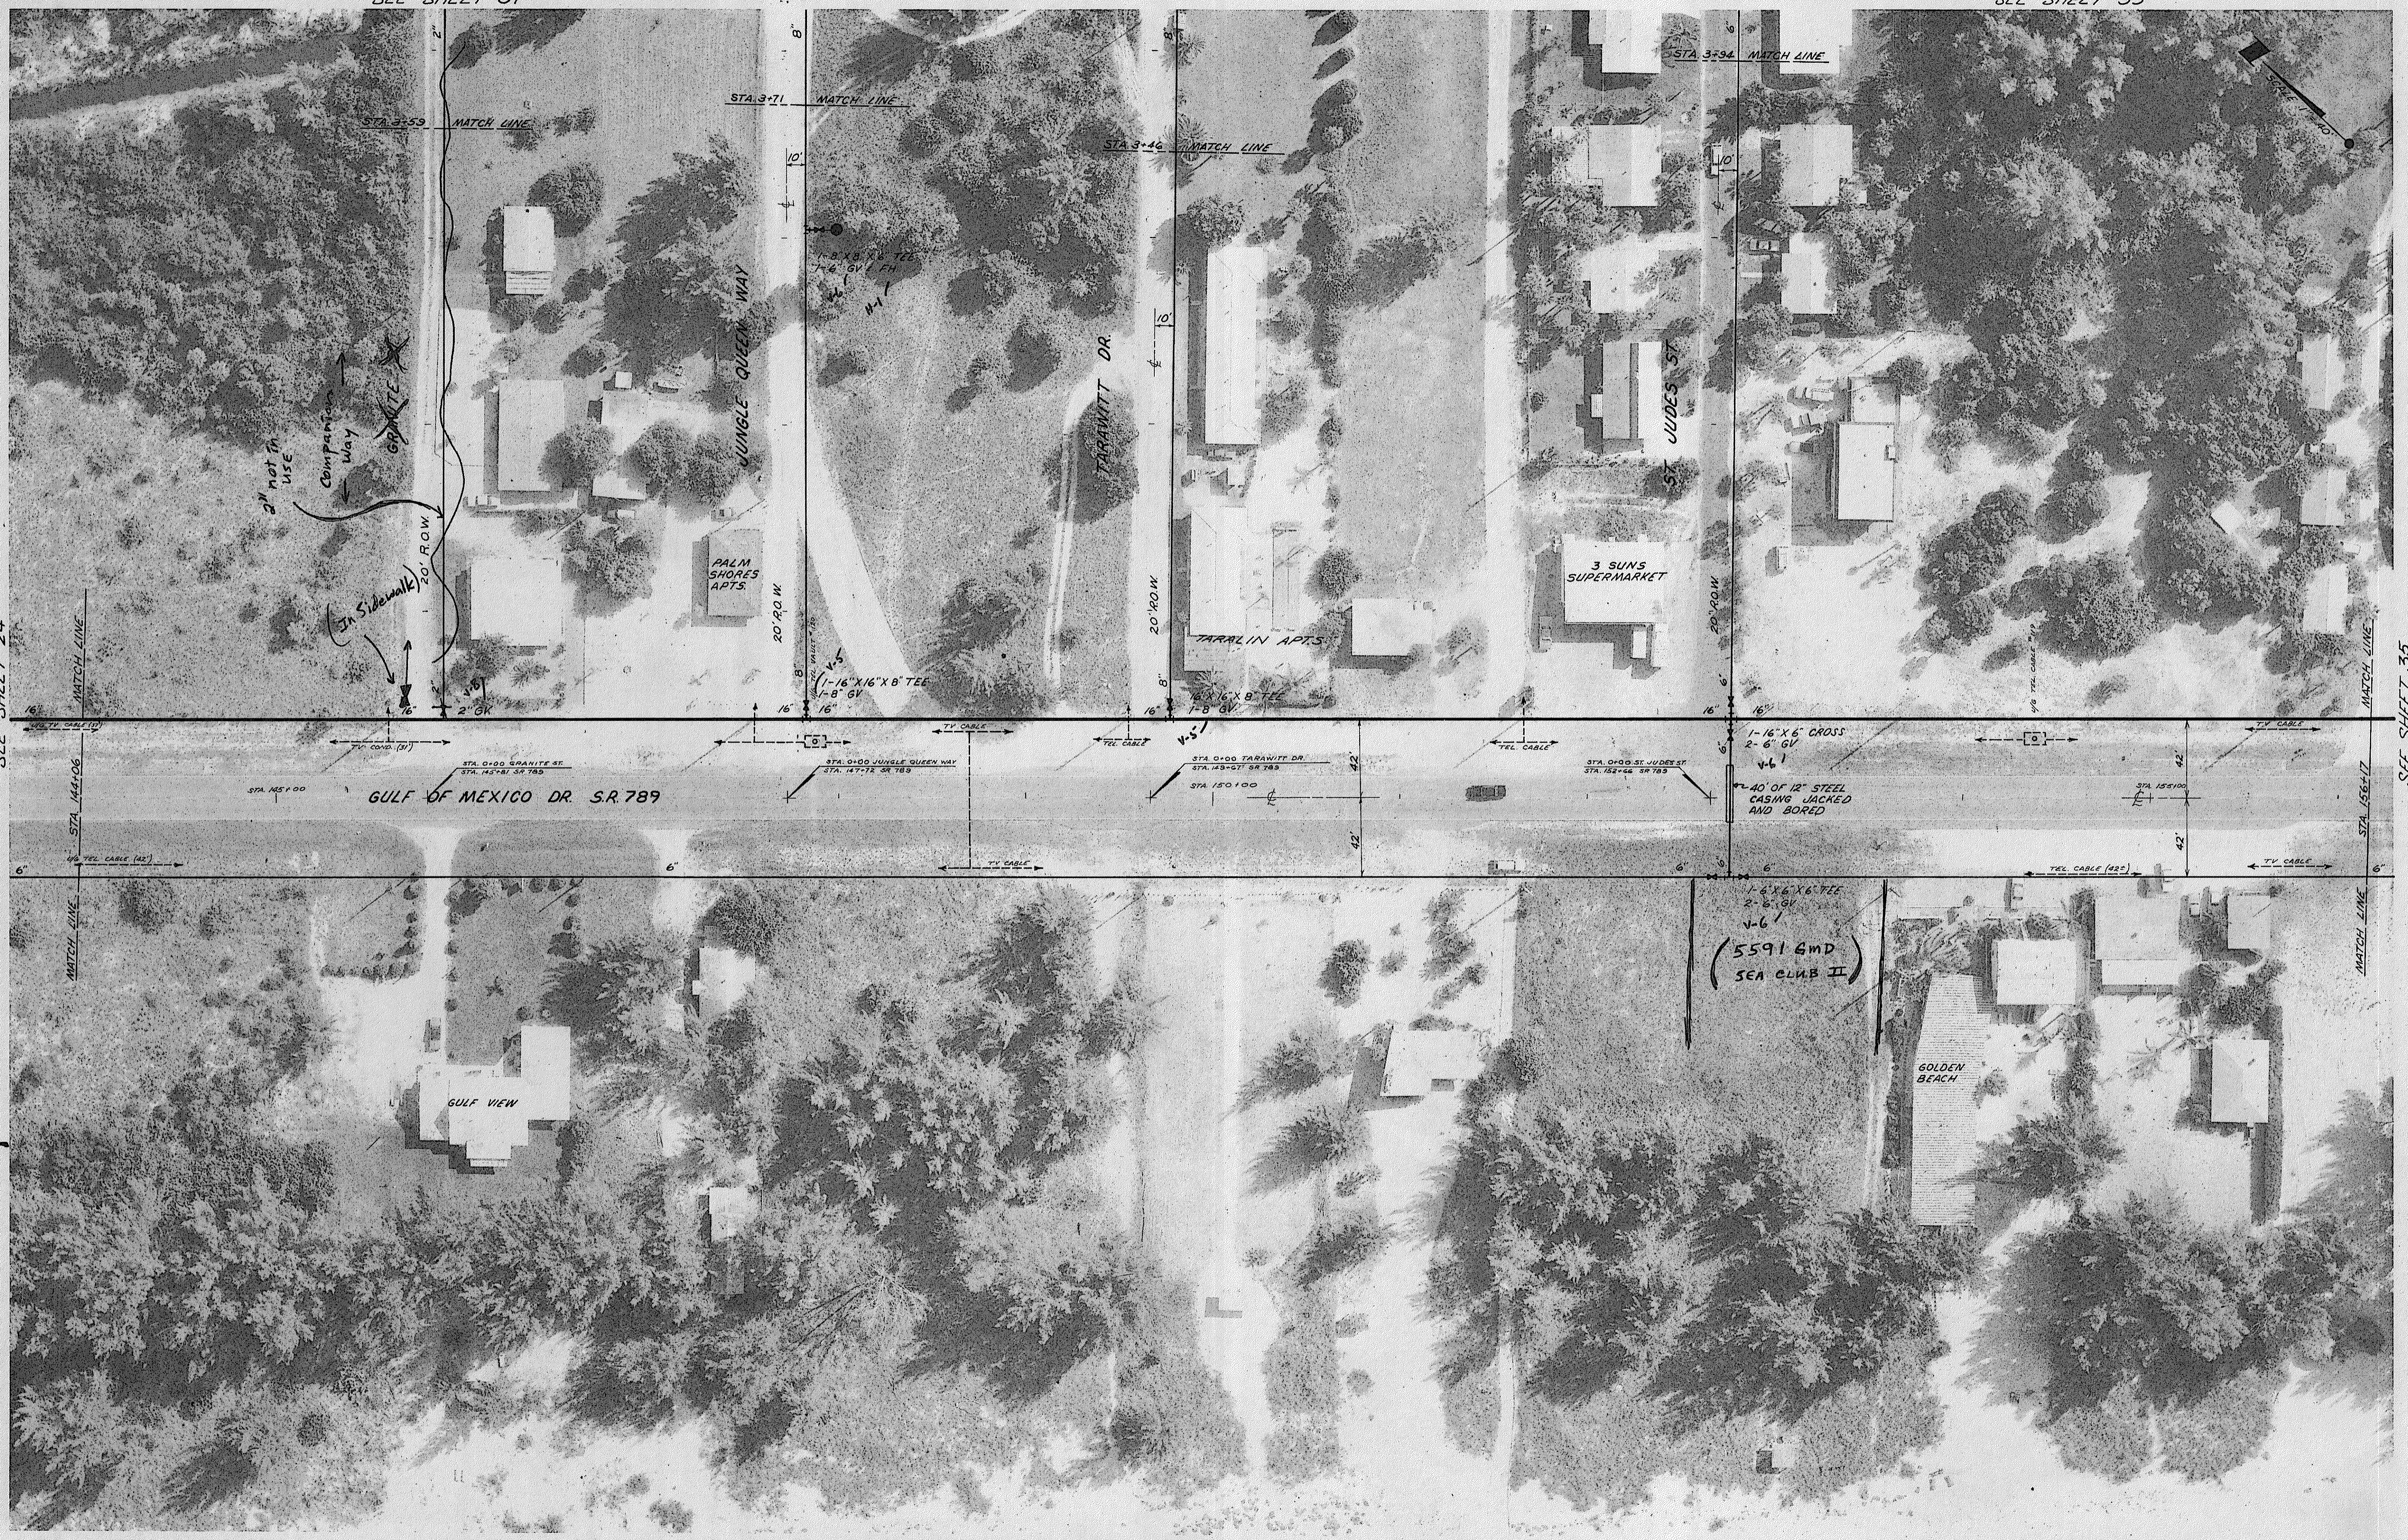

SEE SHEET 24

SEE SHEET 35

FOR: TOWN OF LONGBOAT KEY, FLORIDA	DESIGNED BY APPROVED BY: E.W.N. <i>Marion Wellford, P.E.</i>
PROJECT NO. 1217	CHECKED BY 7ZL
DATE 12-10-70	DRAWN BY 7ZL
SCALE 1" = 40'	BY
L.T.R. DATE	REVISION
WATER DISTRIBUTION SYSTEM LONGBOAT KEY, FLORIDA	
SMALLY · WELLFORD & NALVEN — CONSULTING ENGINEERS — SARASOTA, FLA.	
SHEET NUMBER 30	INDEX NO. E-1217-48
REVISION	