


SEE SHEET 33

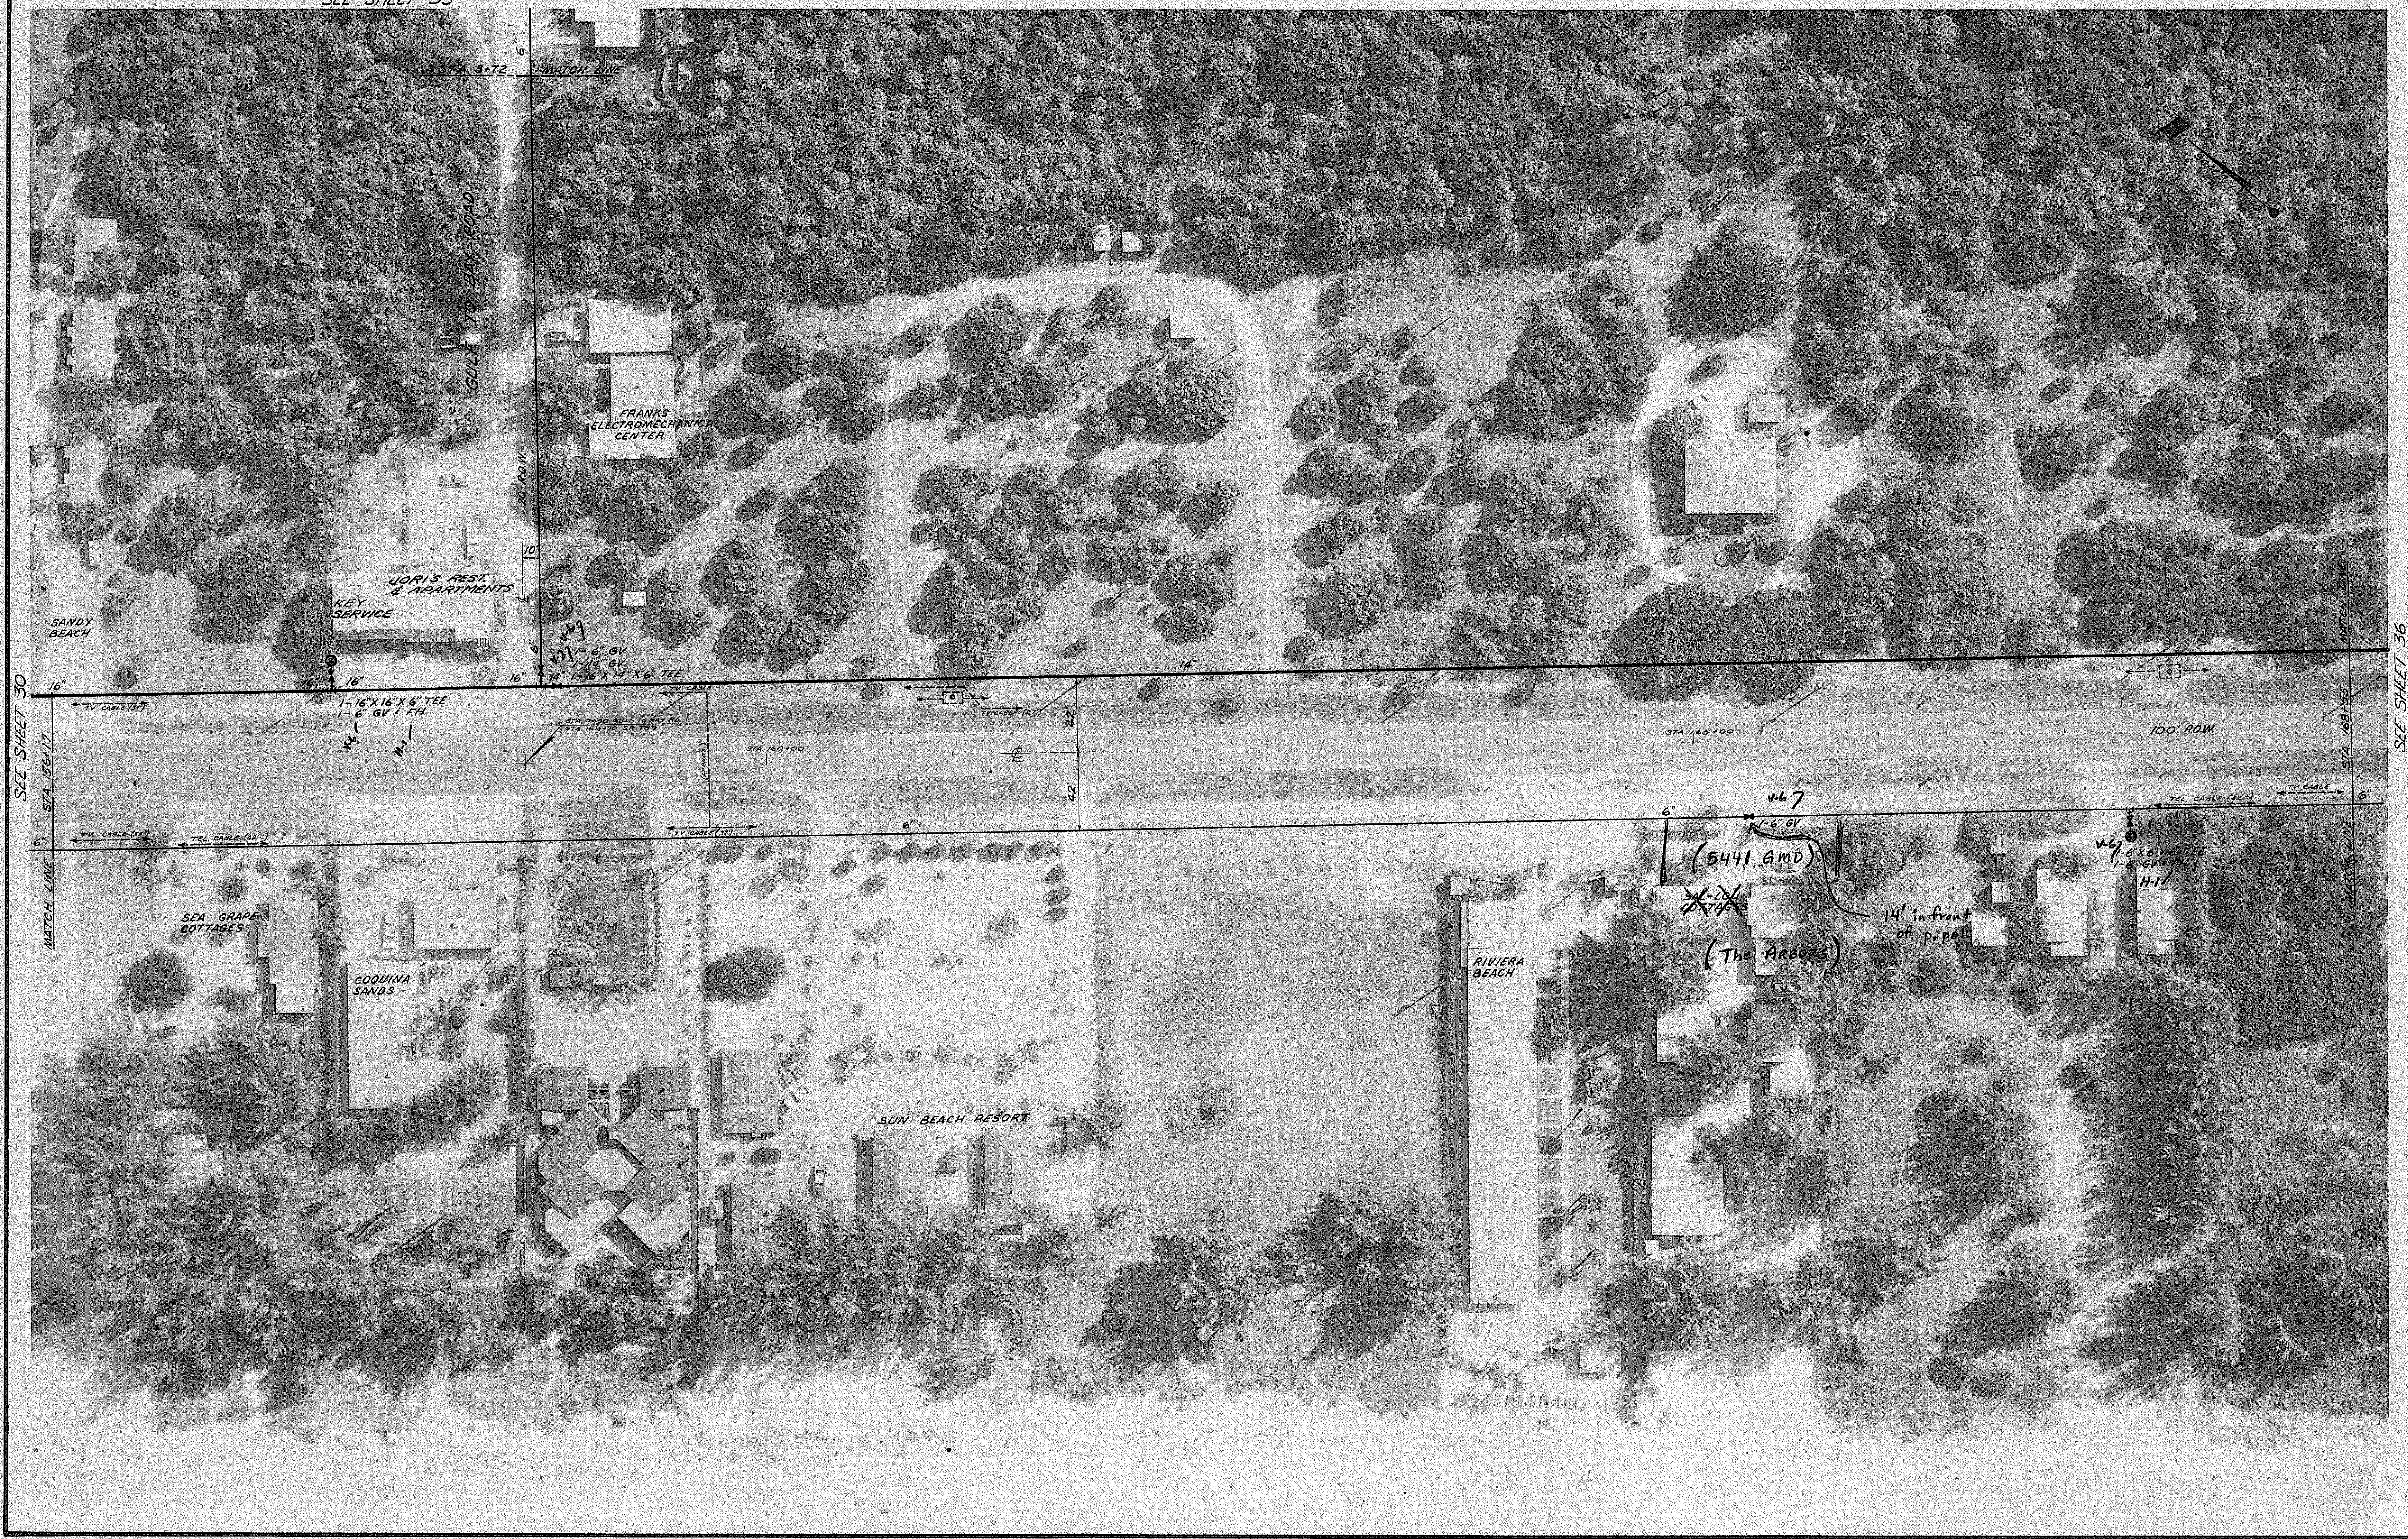

SEE SHEET 30

SEE SHEET 36

FOR: TOWN OF LONGBOAT KEY, FLORIDA	L.T.R. DATE	REVISION	BY	SCALE	DATES	DESIGNED BY	APPROVED BY
WATER DISTRIBUTION SYSTEM LONGBOAT KEY, FLORIDA				1" = 40'	FLORID. SECT. 8, 1970	E.W.N.	Marion Wellford
					12-10-70	CHECKED BY	MARION WELLFORD, P.E. FLA. CERT. NO. 5367
						PROJECT NO.	
						1217	
SMALLY, WELLFORD & NALVEN - CONSULTING ENGINEERS - SARASOTA, FLA.							
SHEET NUMBER	INDEX NO. E-1217-53						
35							
REVISION							