


SEE SHEET 51

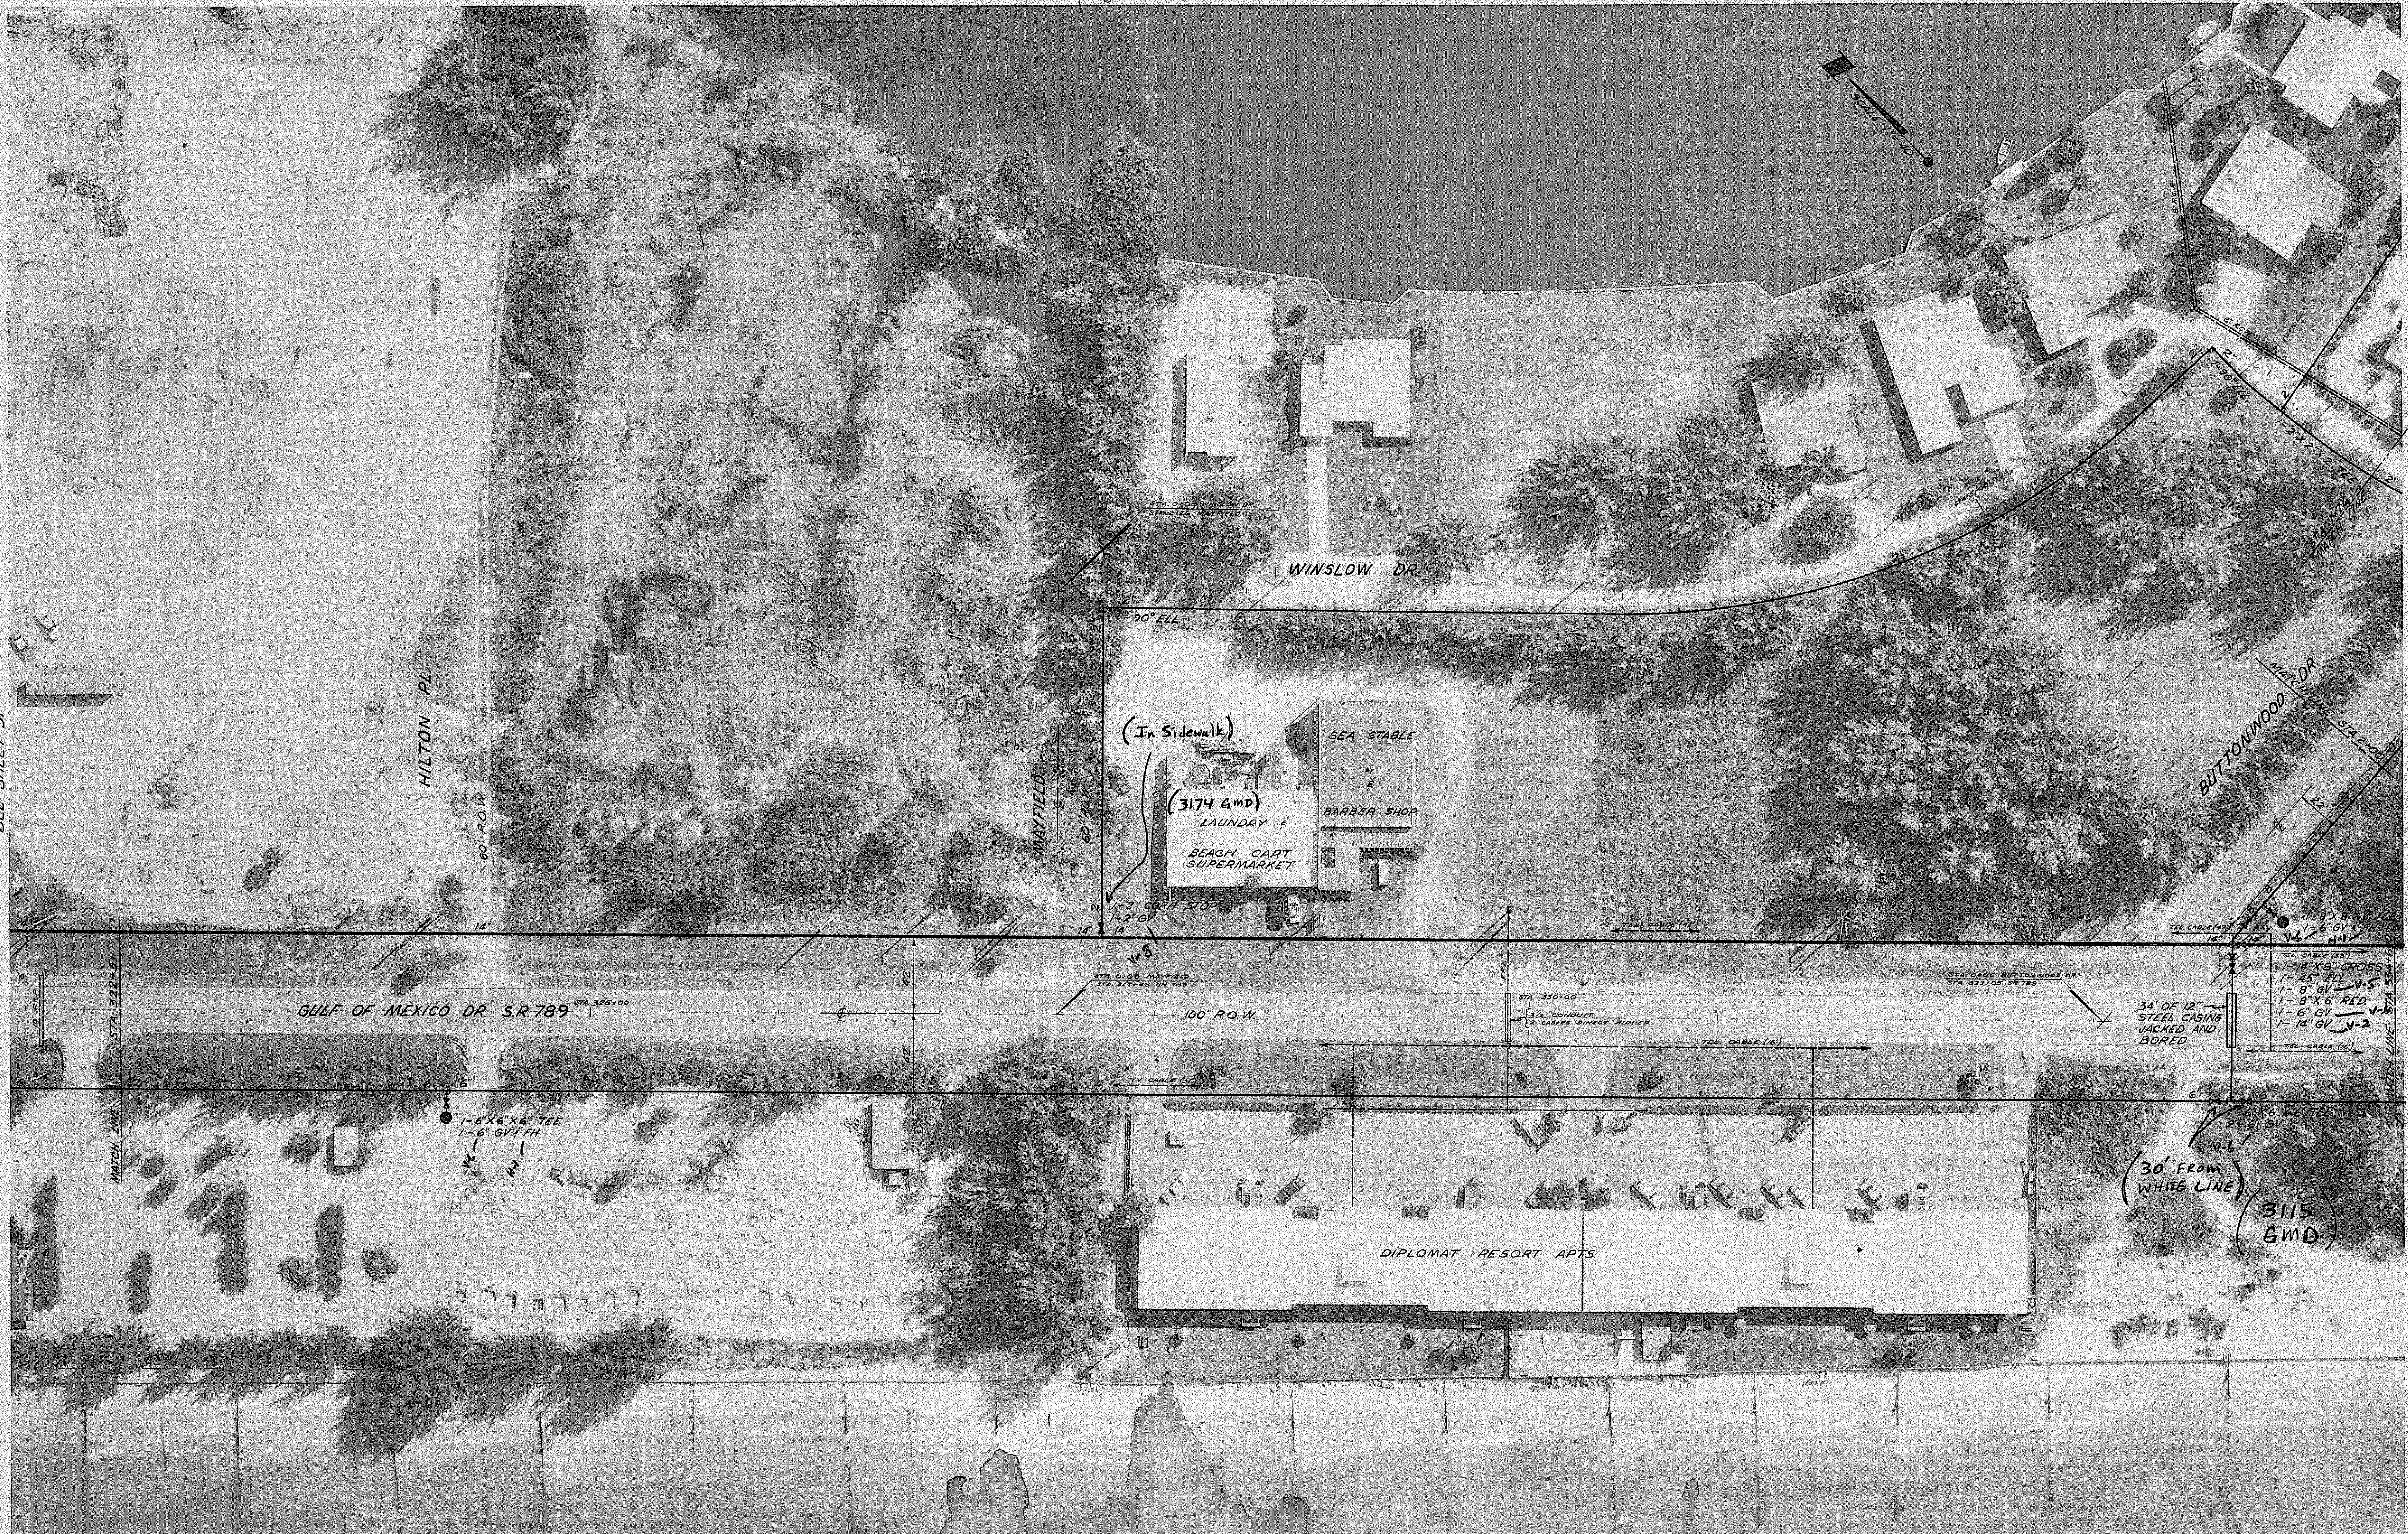

FOR: TOWN OF LONGBOAT KEY, FLORIDA		L.T.R.	DATE	REVISION	BY	SCALE	DATES	DESIGNED BY	APPROVED BY
WATER DISTRIBUTION SYSTEM		21"	12-4-70	ADDED 14" G.I.	Z.D.L.	1" = 40'	FLOW SEPT. 9, 1970 12-10-70	E.W.N.	Marion Wellford
LONGBOAT KEY, FLORIDA							CHECKED BY	PROJECT NO.	MARION WELLFORD P.E. FLA. CERT. NO. 5367
SMALLY · WELLFORD & NALVEN — CONSULTING ENGINEERS — SARASOTA, FLA.							7.L.L.	1217	
SHEET NUMBER		52							
REVISION		24"							

INDEX NO. E-1217-70