


SEE SHEET 53

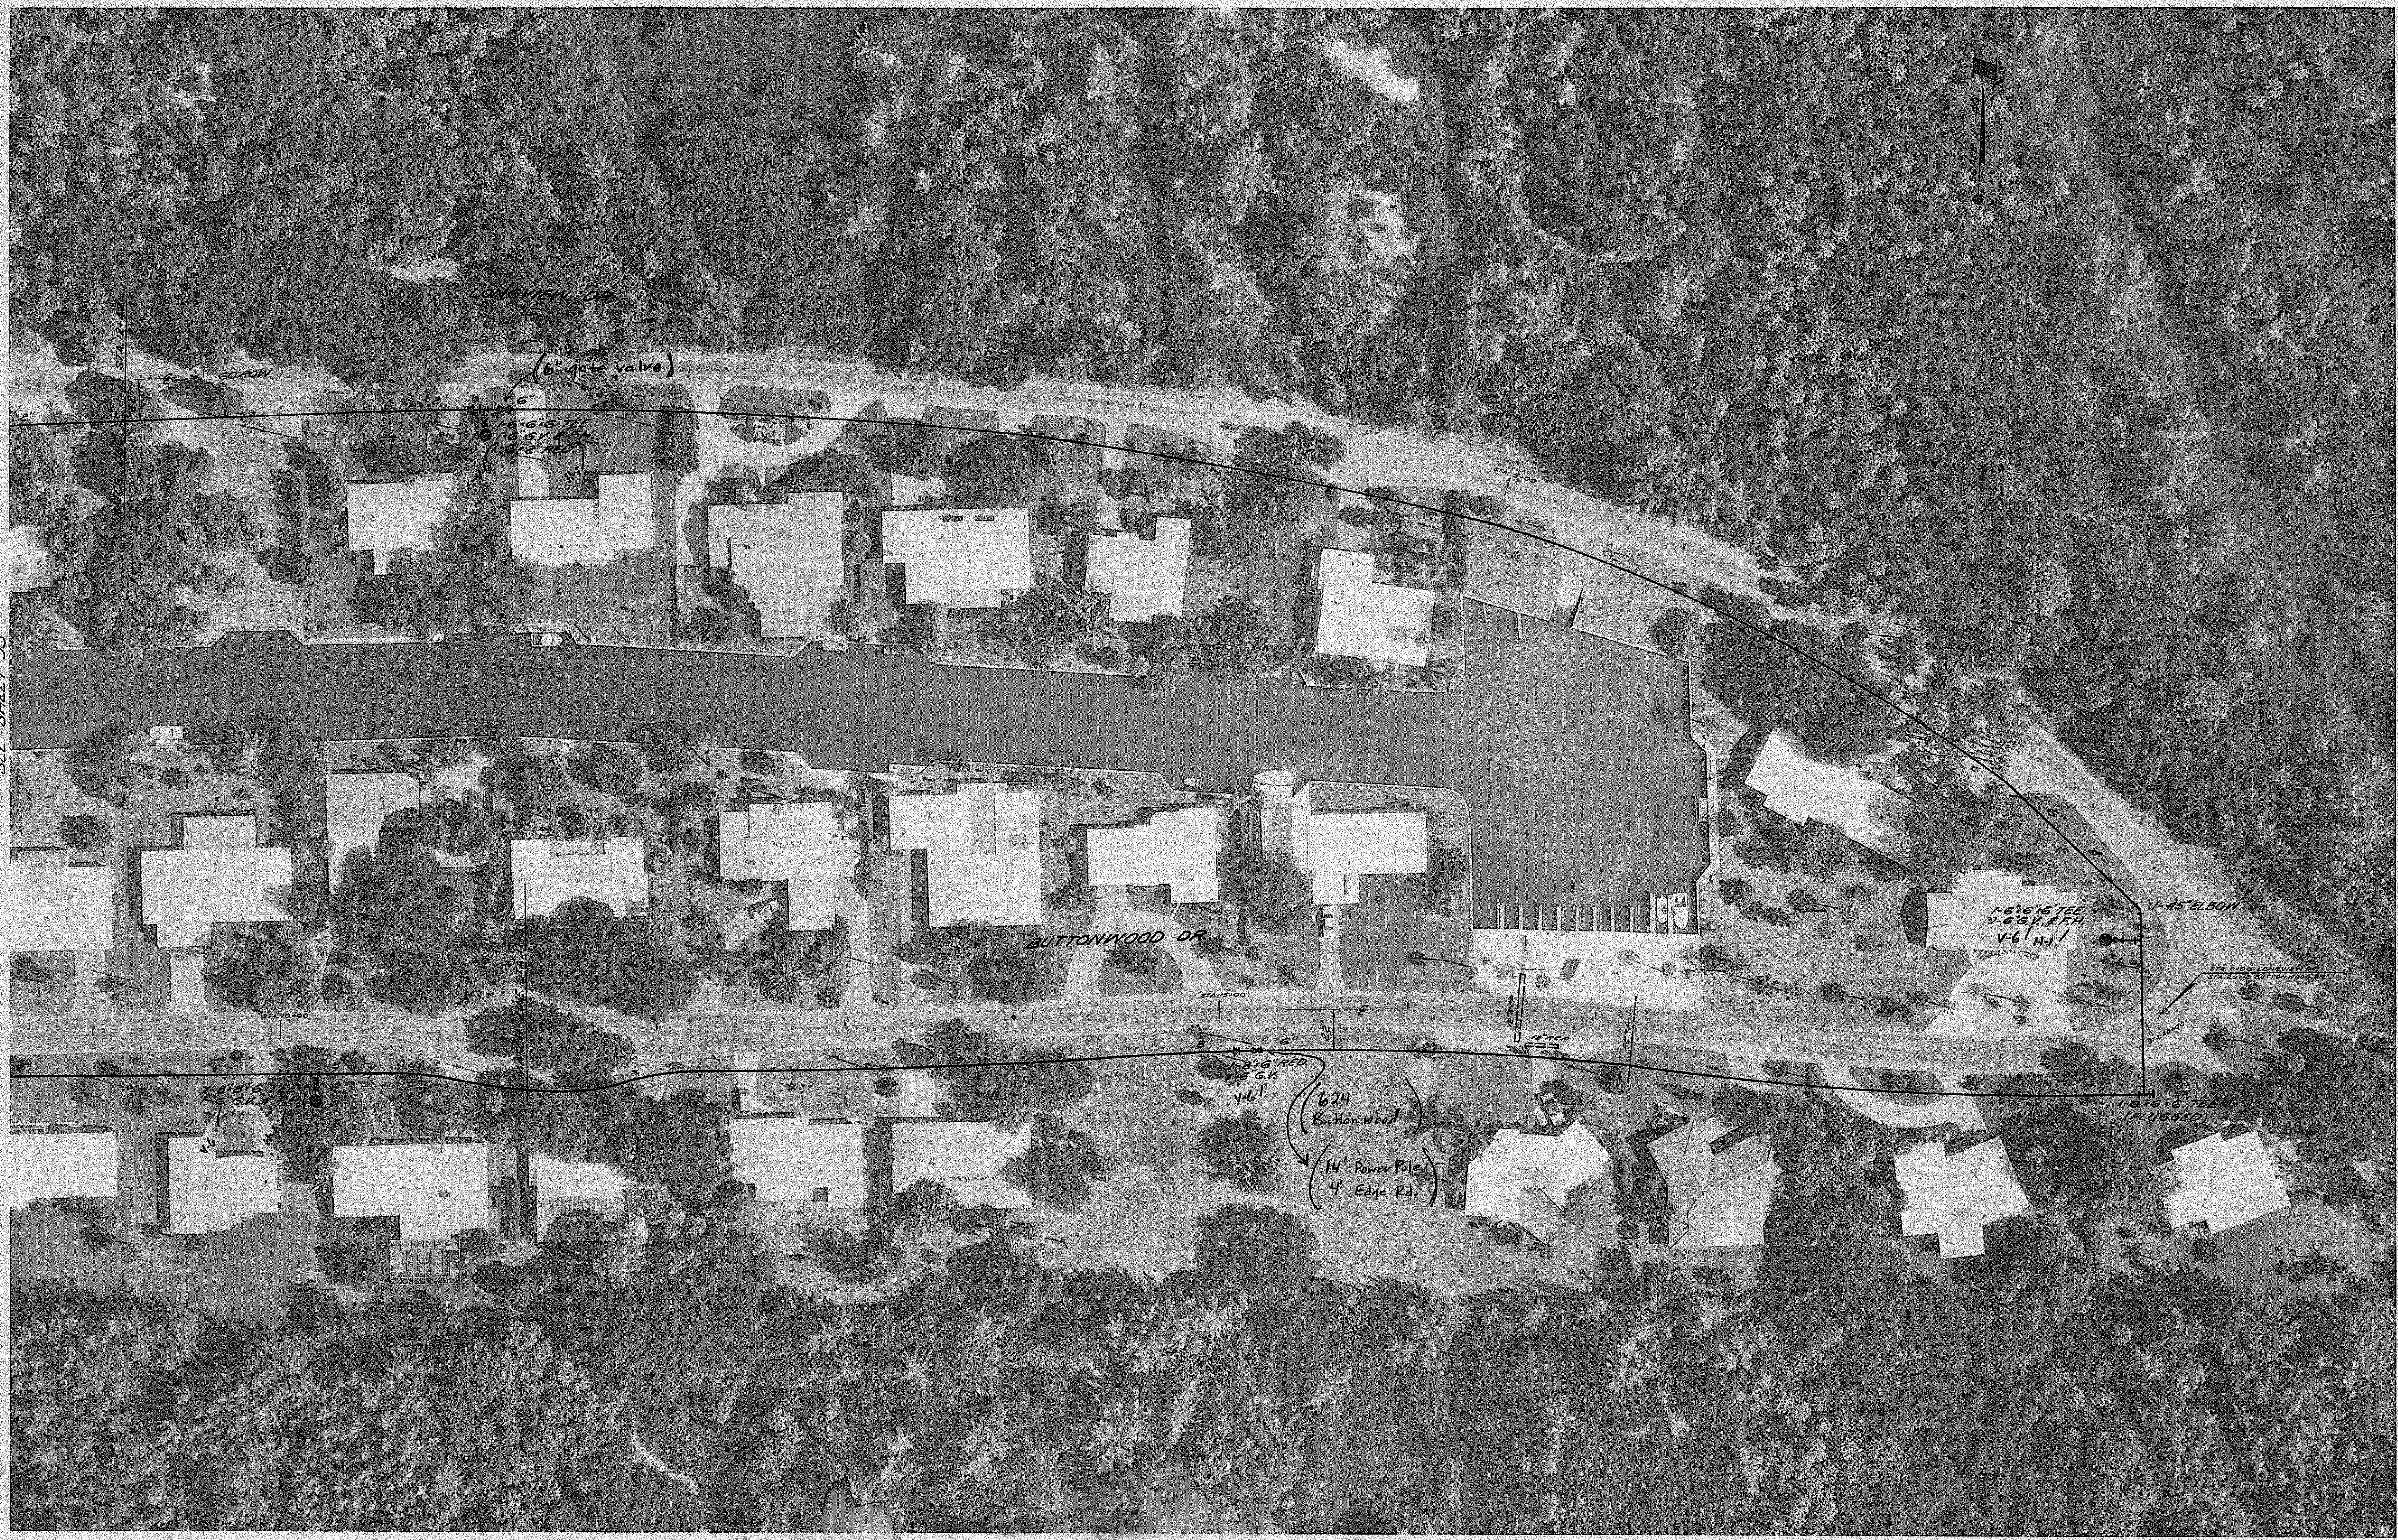

FOR: TOWN OF LONGBOAT KEY, FLORIDA	L.T.R.	DATE	REVISION	BY	SCALE	DATES	DESIGNED BY	APPROVED BY
WATER DISTRIBUTION SYSTEM LONGBOAT KEY, FLORIDA					1" = 40'	FROM SEP. 9, 1970 12-10-70	E.W.N.	<i>M. Wellford</i>
	SHEET NUMBER				DRAWN BY	CHECKED BY	PROJECT NO.	MARION WELLFORD, P.E. FLA. CERT. NO. 5367
REVISION					8029		1217	
SMALLY · WELLFORD & NALVEN — CONSULTING ENGINEERS — SARASOTA, FLA.								

54

INDEX NO. E-1217-72