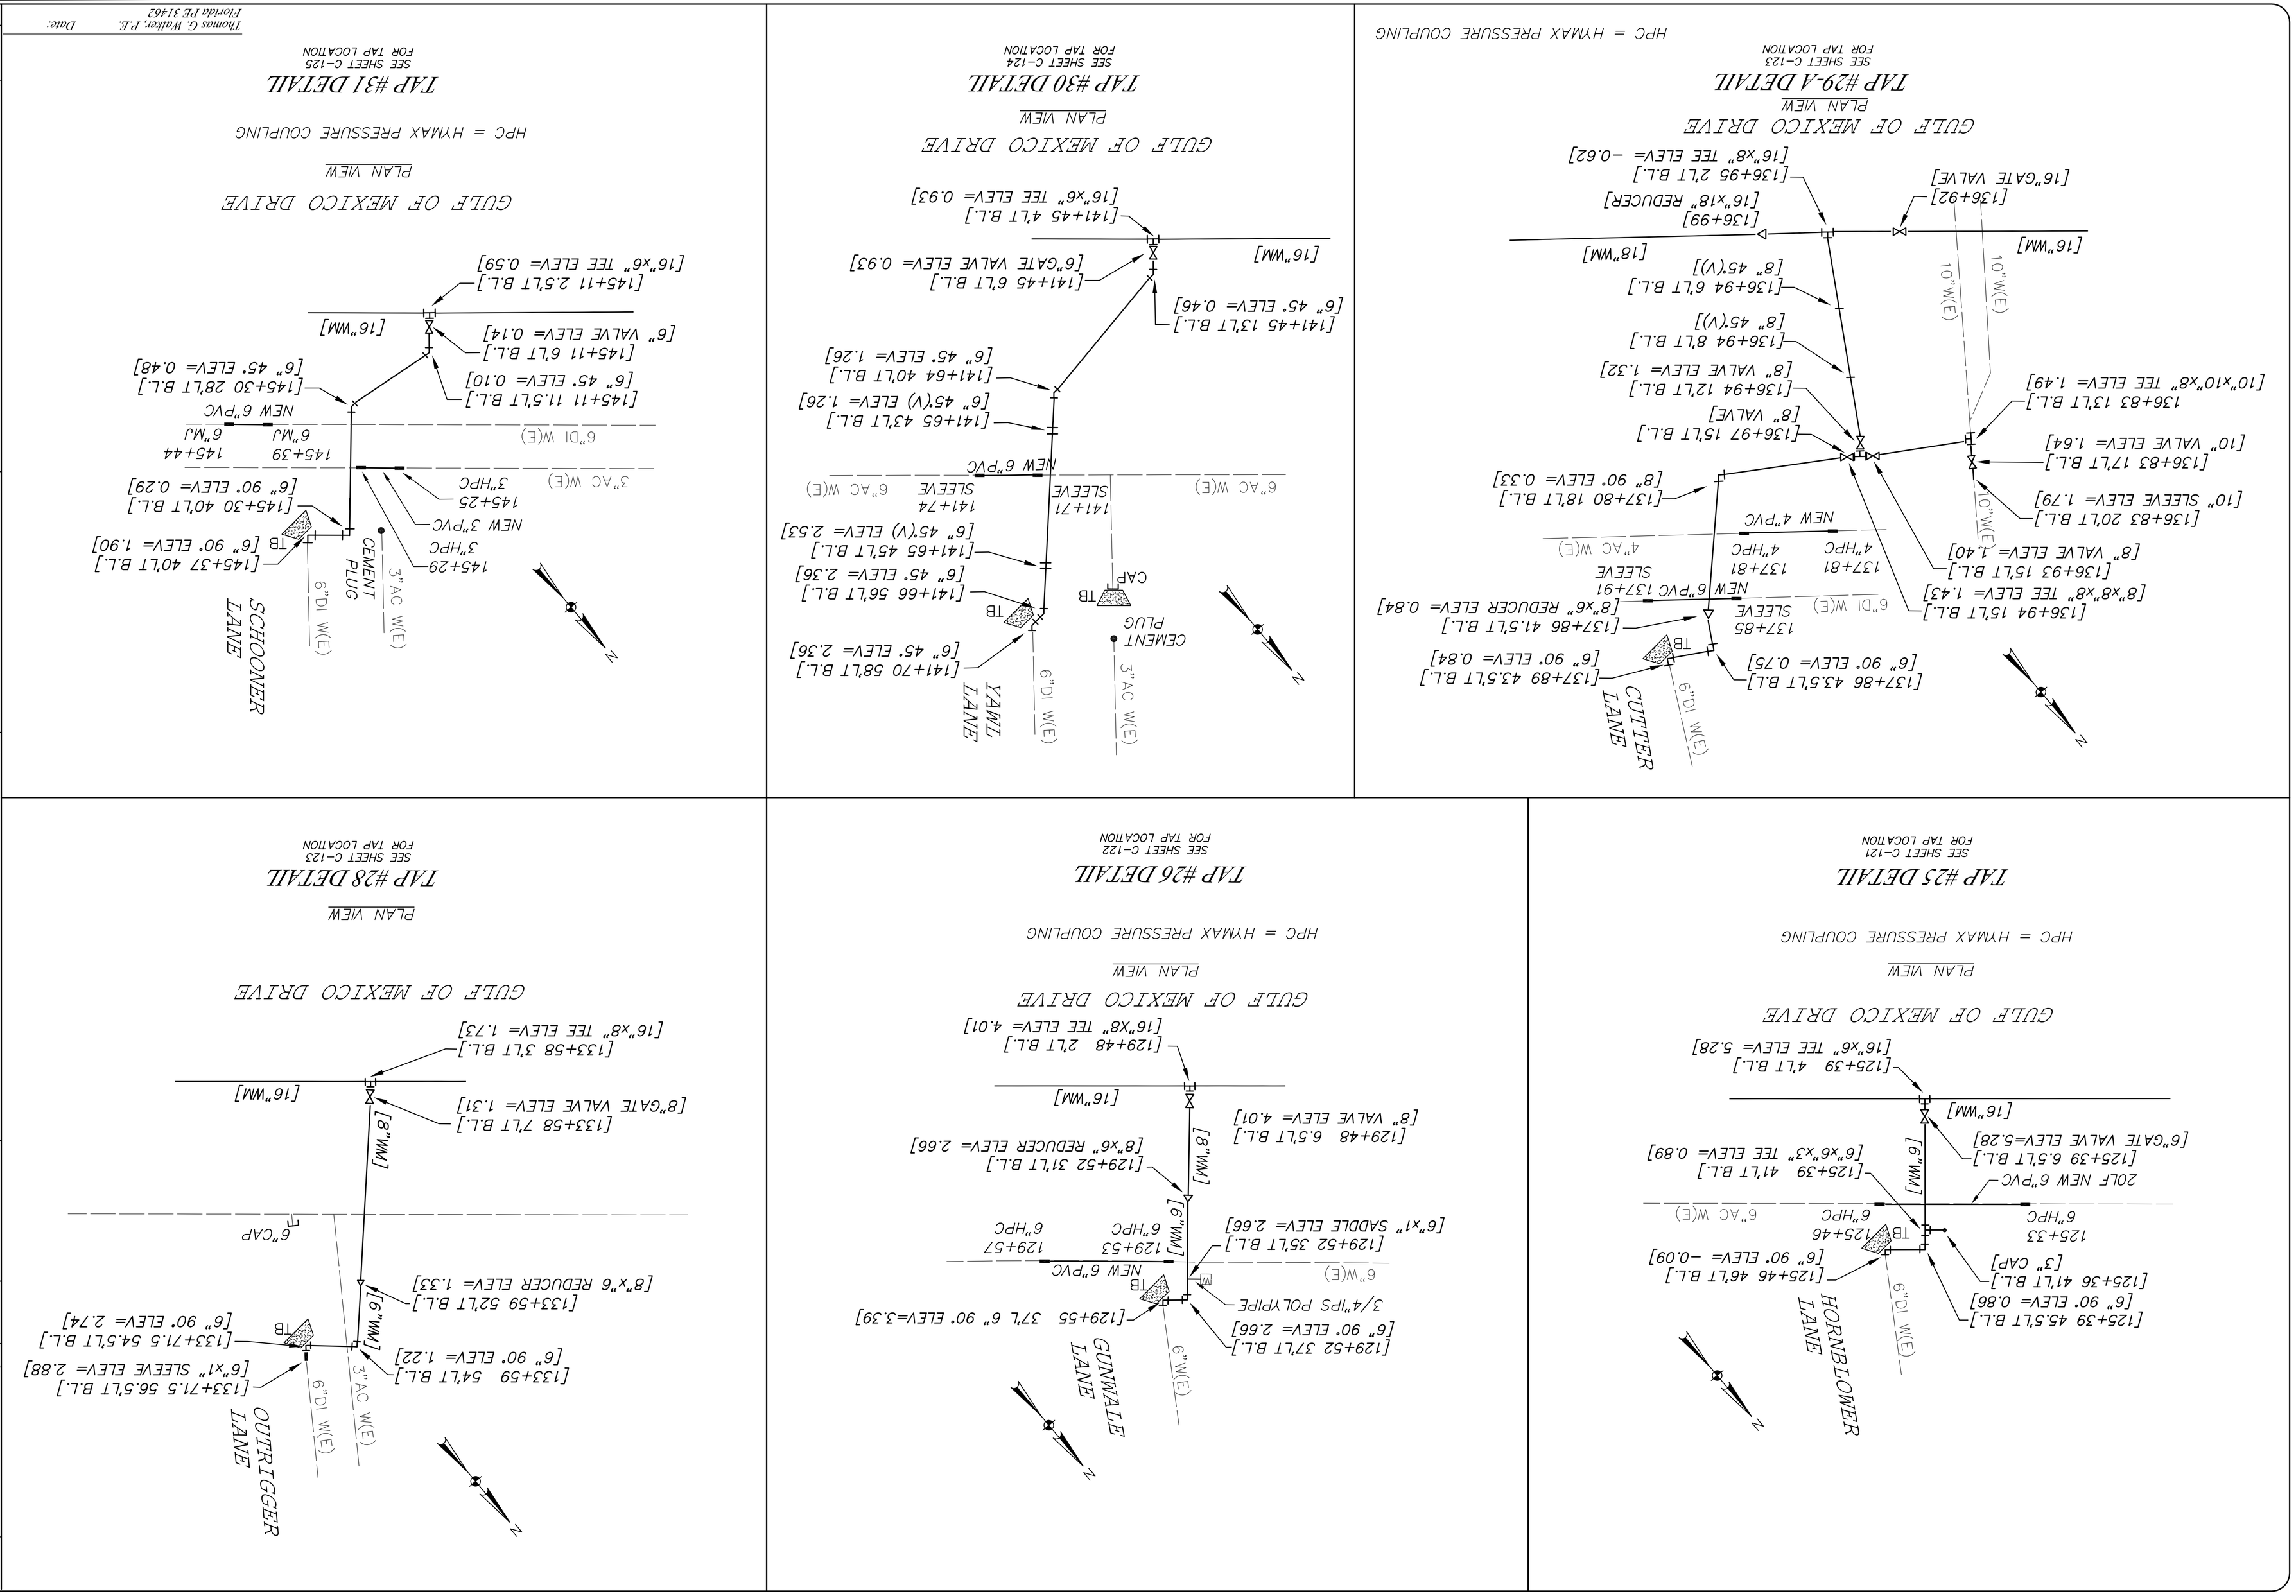

DRAWING SIZE 24" x 36" – USE GRAPHIC SCALE OTHERWISE.

TAP DETAILS

UPSIZE POTABLE WATER TRANSMISSION MAIN

TOWN OF LONGBOAT KEY, SARASOTA COUNTY, FLORIDA

ENGINEERING VISIONS, INC.
FL COA# 27192
3906 MYERS PARKWAY
SARASOTA, FL 34232
PH:(941) 355-0000, FAX:(941) 355-0006

PARTNERSHIP

ENGINEERING, INC.
FL COA# 26755
3906 MYERS PARKWAY
SARASOTA, FL 34232
PH:(941) 355-0000, FAX:(941) 355-0006

Thomas G. Willer, P.E.
Florida PE 31462
Date:

PROJECT MANAGER:	LAURA S. ANDREWS, PE
FILE NAME:	LBK_WM_T-100.DWG
DESIGNED BY:	LSA/TGW
DRAWN BY:	KP
ACCOUNT:	
DATE	10/17/08

NO.	REVISIONS	DATE
1	CONFORMED DRAWING	11/04/09
2	ASBUILT DRAWINGS	6/13/11

DRWG. NO: T-104

SHT. 60